


**- Cooler - Tile after Walk-in Installation.** If tiled after installation, tile must be completed before walk-in installer leaves the site. If not, GC will have to secure the thresholds to the tile and install the slam brace.



\*\*\*\*\*The floor tile helps keep the wall panels in place along with the slam braces. After the panel installation, the tile and slam braces must be installed as soon as possible; otherwise, the door and door frame can be knocked out of alignment. This could cause issues with the door sealing correct. The KES or Installer is not responsible for any issues caused by the move of the panel if the tile and slam braces are not installed before the installer leaves the site.

Freezer - Recessed Floor w/Diamond Plate Overlay

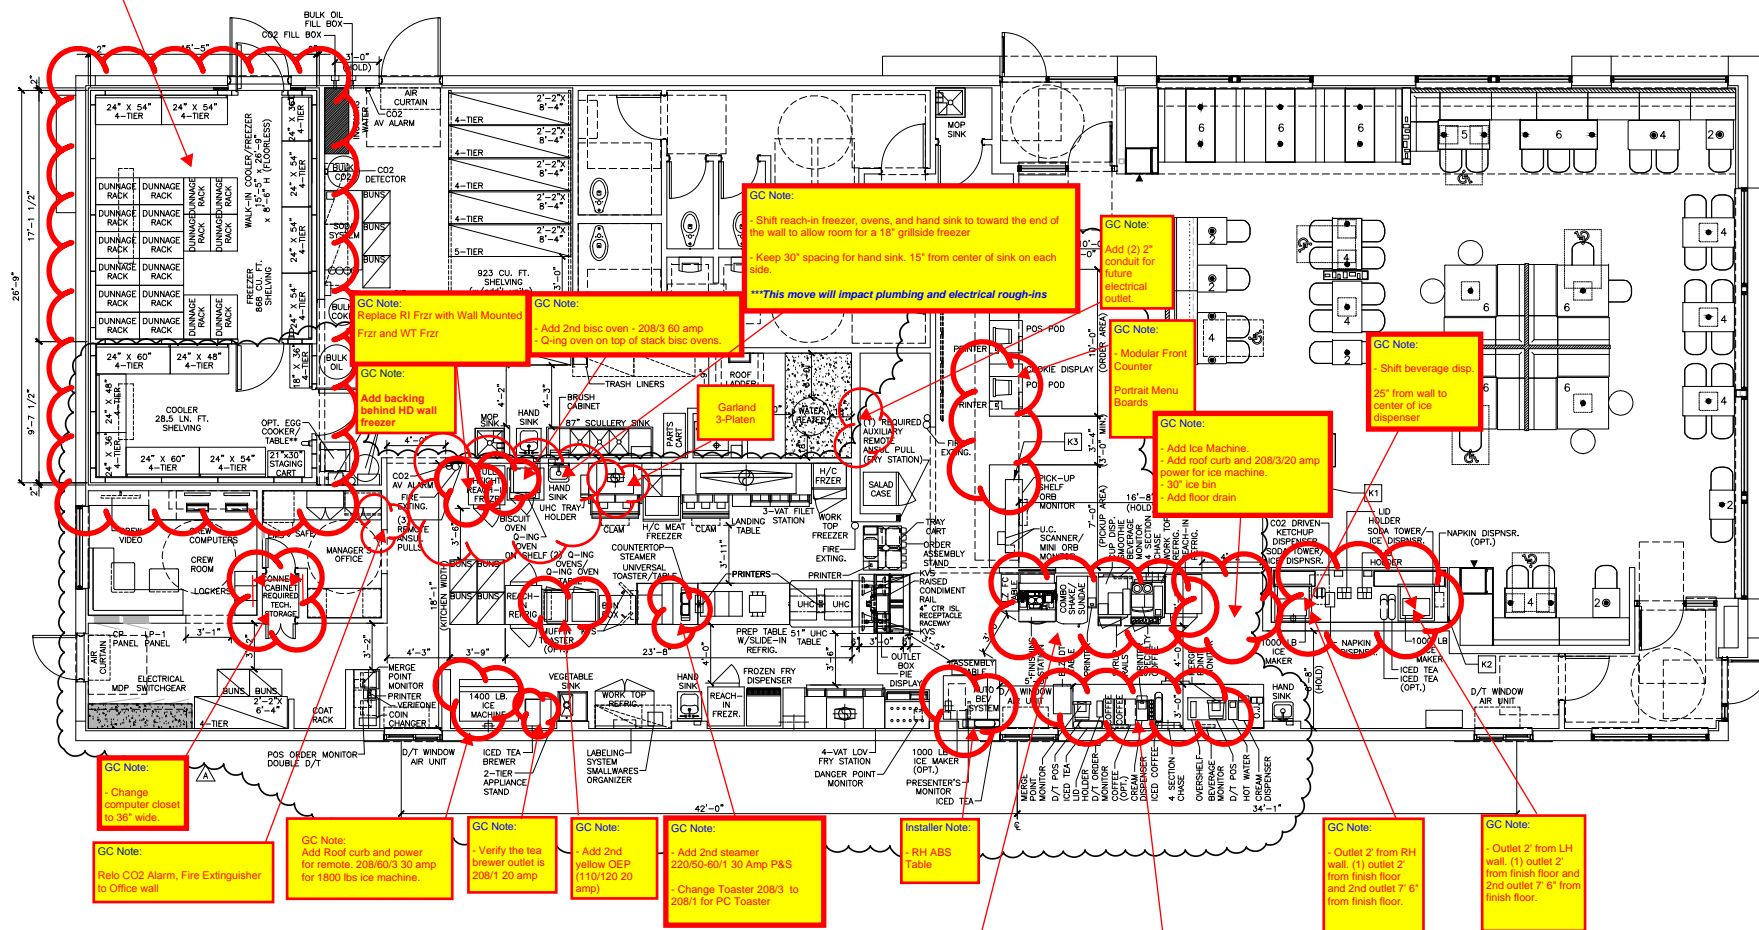

- K1** SEATING AND DINING WALL MUST BE 4'-0" CLEAR FROM BEVERAGE CELL WALL
- K2** KES TO ENSURE SELF-SERVE BEVERAGE BAR EQUIPMENT PLACEMENT MEETS ADA REQUIREMENTS
- K3** 5'-0" PICK-UP SHELF  
SEE DETAIL ON SHEET A4.0

\* DENOTES BREAKFAST EQUIPMENT IN PARKED POSITION DURING REGULAR MENU OPERATIONS

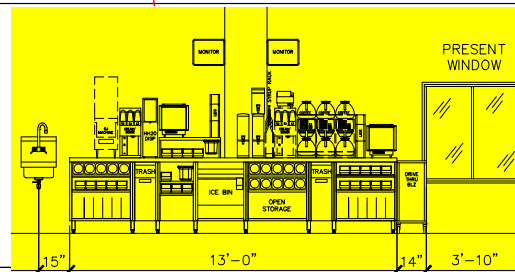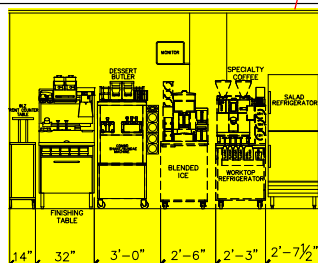

KITCHEN COVER SHEET

 $1/4" = 1'-0"$