


3D VIRTUAL TOUR LINK
(PDF DRAWING VERSION ONLY)
CLICK TO VIEW THE THREE
DIMENSIONAL WALKTHROUGH
ON YOUR BROWSER



QR CODE VIRTUAL TOUR LINK
QR CODE ALLOWS ACCESS TO
VIRTUAL WALKTHROUGH FROM
PRINTED COPY IF NEEDED

- LEGEND**
- EXISTING EQUIPMENT
 - EXISTING TRUSSES
 - SERVICE AREA
 - OVERHEAD
 - EXISTING FULL WALL
 - EXISTING LOW WALL

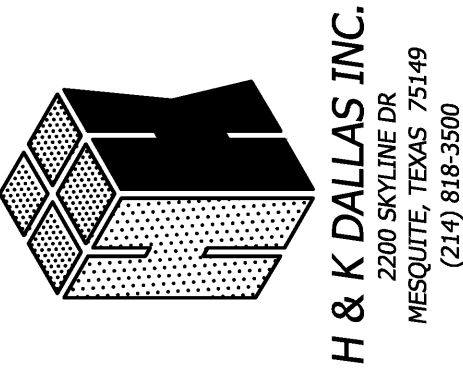

DATE:	21APR17	DATE:	-	DATE:	-
DRAWN:	UA	DRAWN:	-	DRAWN:	-
CHECKED:	BD	CHECKED:	-	CHECKED:	-
SCALE:	SEE PLAN	SCALE:	-	SCALE:	-

TITLE: REMODEL DRAWING
AS-BUILT LAYOUT
21320 HWY 22
WILDERSVILLE, TN

CUSTOMER: McDONALD'S CORPORATION
Oak Brook, Illinois

STORE NO: 27434

SHEET: 4 OF 11

SHEET NO: AB-4

ELITE CONSTRUCTION GROUP
LAKE JACKSON, TX
PHONE: 979-285-0712
NOTE: THESE PRINTS HAVE BEEN
REDUCED BY 50 PERCENT. SCALE
WILL BE 50 PERCENT OF WHAT IS
NOTED ON PLANS

THESE DRAWINGS SPECIFICATIONS ARE THE
PROPERTY OF HBK AND SHALL NOT BE REPRODUCED
OR COPIED WITHOUT HBK'S WRITTEN PERMISSION.