


DRAWING FILE NAME: 27434AB MRP 04-21-17









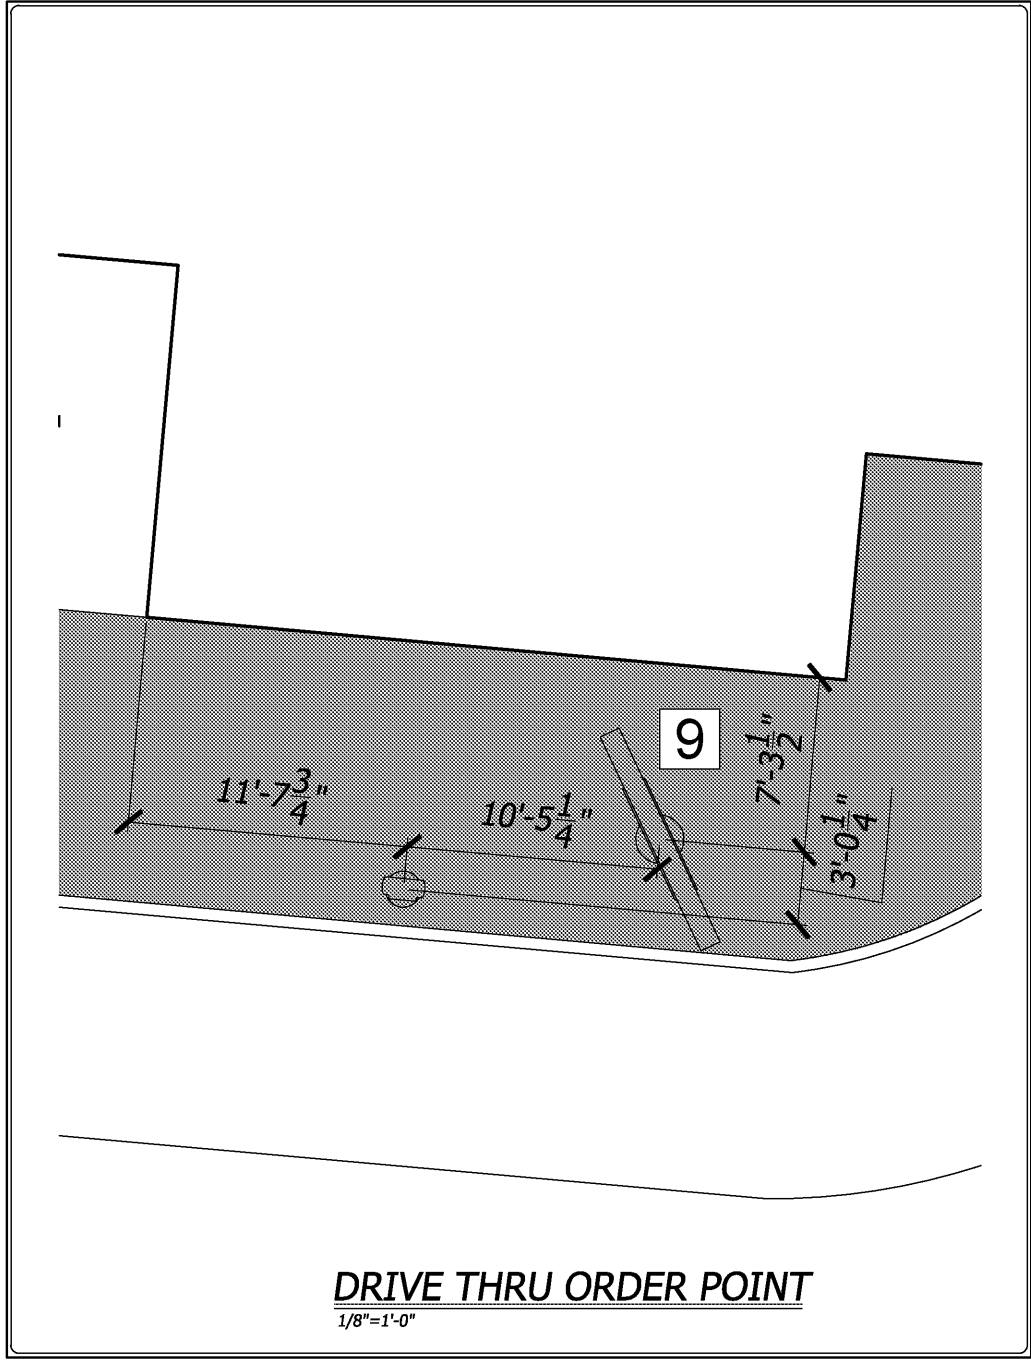








3D VIRTUAL TOUR LINK
(PDF DRAWING VERISION ONLY)
CLICK TO VIEW THE THREE
DIMENSIONAL WALKTHROUGH
ON YOUR BROWSER



QR CODE VIRTUAL TOUR LINK
QR CODE ALLOWS ACCESS TO
VIRTUAL WALKTHROUGH FROM
PRINTED COPY IF NEEDED



SITE PLAN LEGEND		TAG LEGEND					
	PROPERTY LINE	1	MAIN SIGNAGE	5	PLAYPLACE	9	DRIVE THRU ORDER POINT
	LANDSCAPE PERIMETER LINE	 2	ENTRANCE SIGN	 6	FLAG POLE	 10	EXTERIOR TRASH
	BUILDING PERIMETER LINE	 3	LIGHT POLES	 7	MAIN ENTRY	 11	EXTERIOR SERVICES
	PARKING AND OBJECT LINE	 4	EXTERIOR SEATING	 8	SIDE ENTRY	 12	EXIT SIGN
	GRASS						
	BUILDING						

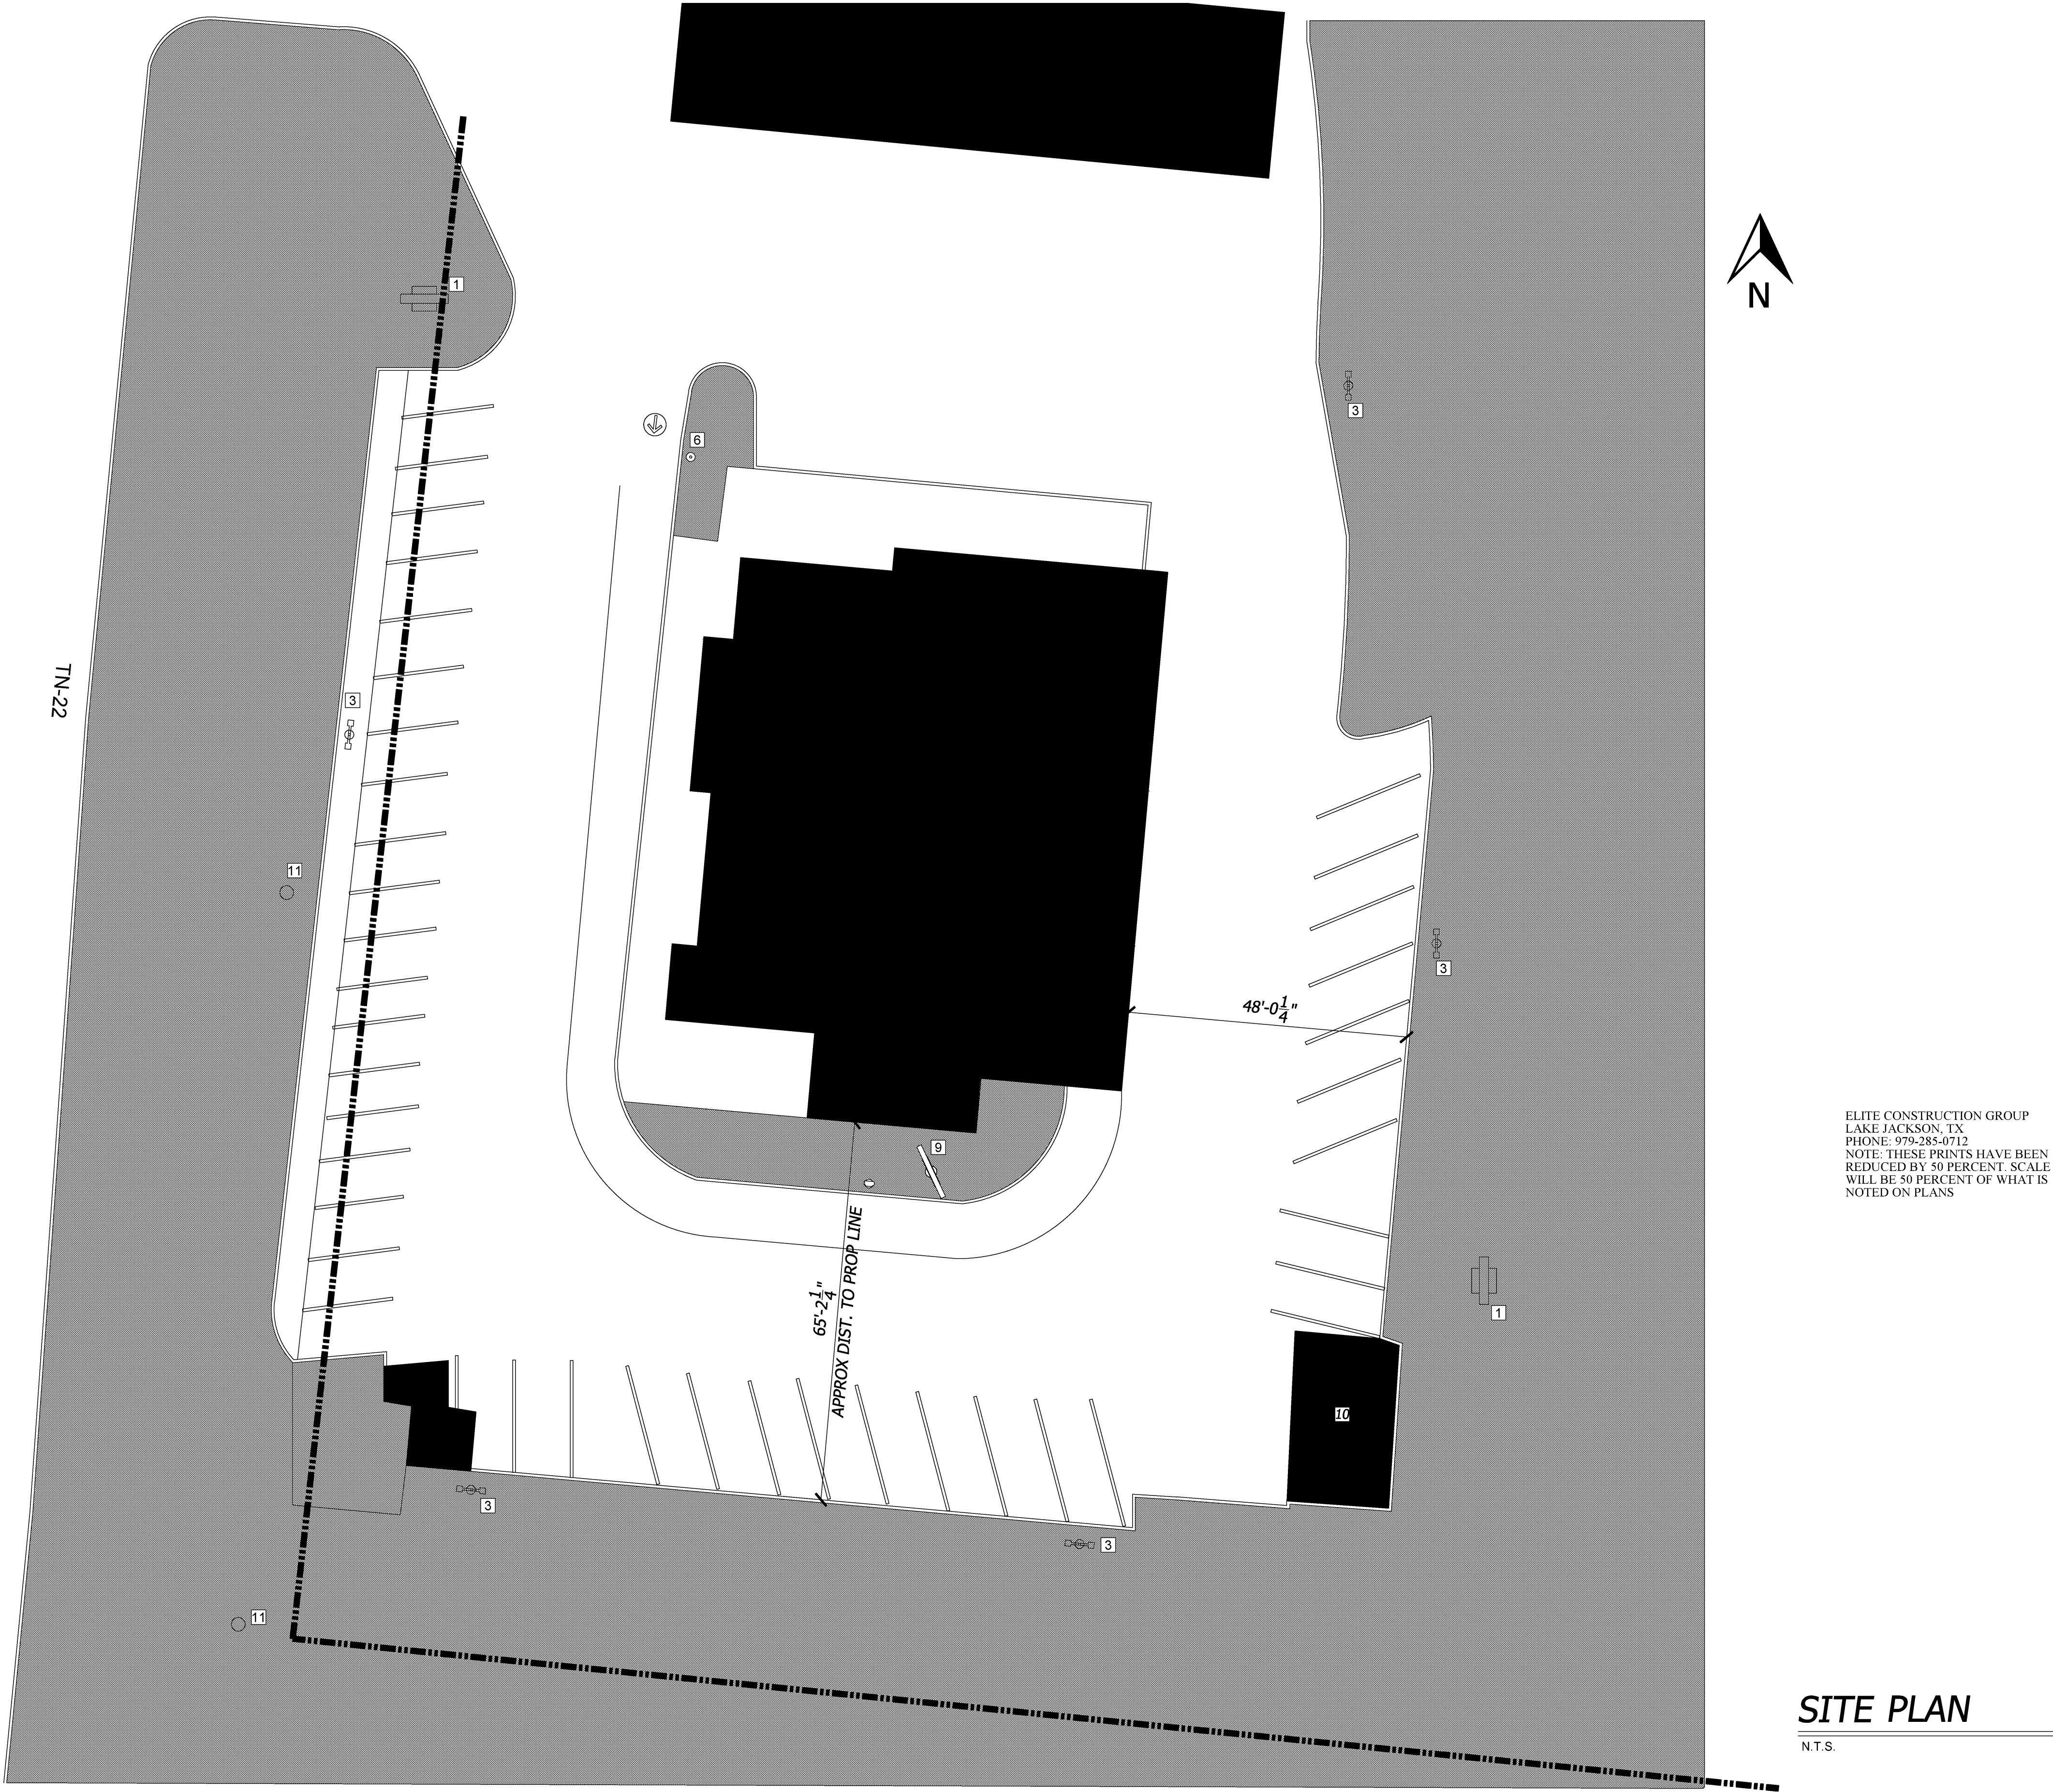

<div>CUSTOMER:<div>MCDONALD'S CORPORATION</div><div>Oak Brook, Illinois</div></div>		<div>TITLE:<div>REMODEL DRAWING</div><div>AS-BUILT LAYOUT</div><div>21320 HWY 22</div><div>WILDERSVILLE, TN</div></div>	<div><div><div><div><div></div><div></div><div></div><div></div><div></div><div></div><div></div><div></div><div></div><div></div><div></div><div></div><div></div><div></div><div></div><div></div><div></div><div></div><div></div><div></div><div></div><div></div><div></div><div></div><div></div><div></div><div></div><div></div><div></div><div></div><div></div><div></div><div></div><div></div><div></div><div></div><div></div><div></div><div></div><div></div><div></div><div></div><div></div><div></div><div></div><div></div><div></div><div></div><div></div><div></div><div></div><div></div><div></div><div></div><div></div><div></d---	--	---	---	--	--	--