



FRONT ELEVATION
SCALE : 3/16" = 1'

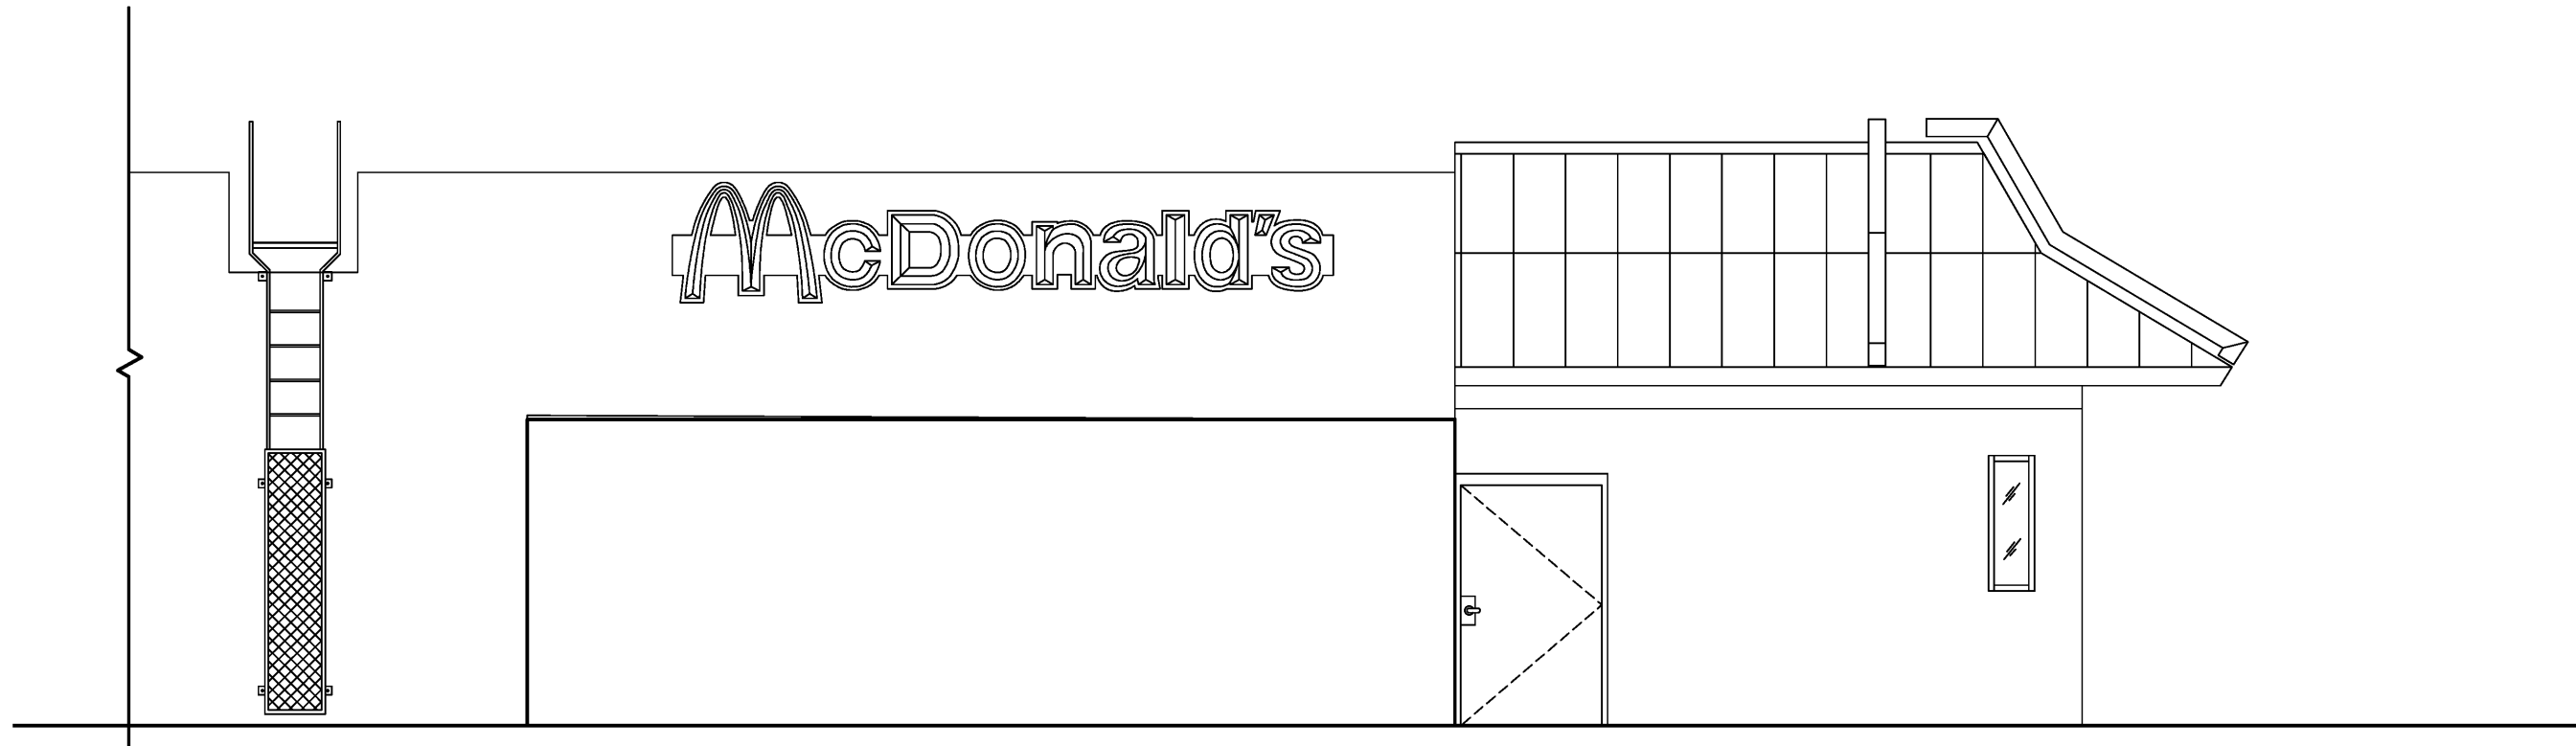

BACK ELEVATION
SCALE : 3/16" = 1'


NO SURVEY FO RIGHT SIDE VIEW

SIDE ELEVATION
SCALE : 3/16" = 1'

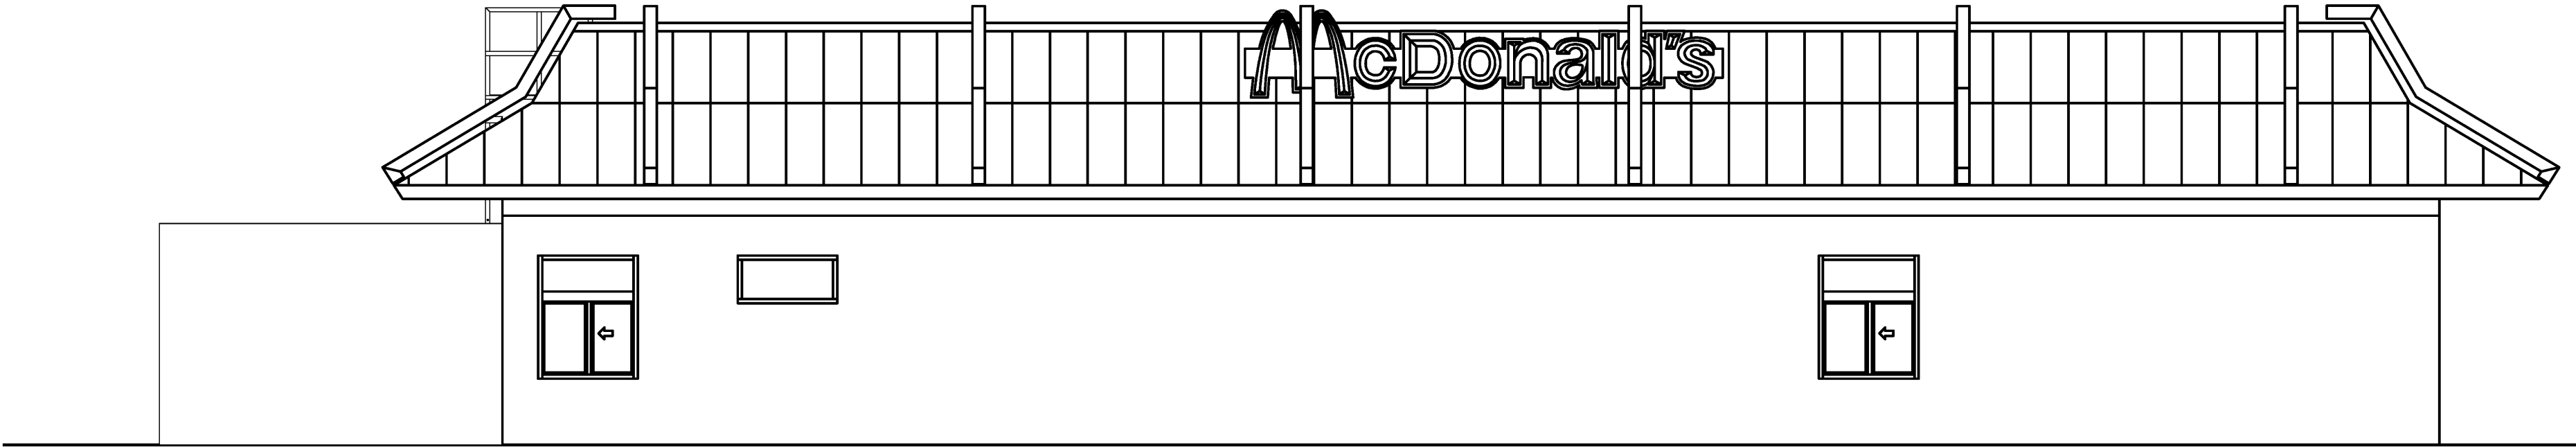

SIDE ELEVATION
SCALE : 3/16" = 1'

ELITE CONSTRUCTION GROUP
LAKE JACKSON, TX
PHONE: 979-288-0712
NOTE: THESE PRINTS HAVE BEEN
REDUCED BY 50 PERCENT. SCALE
WILL BE 50 PERCENT OF WHAT IS
NOTED ON PLANS

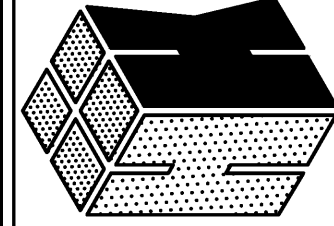

H & K DALLAS INC.
2200 SKYLINE DR
MESQUITE, TEXAS 75149
(214) 818-5500

DATE:	REVISION	BY
21APR17		
DRAWN: UA	-	-
CHECKED: BD	-	-
SCALE: SEE PLAN	-	-

TITLE: REMODEL DRAWING AS-BUILT LAYOUT 21320 HWY 22 WILDERSVILLE, TN THESE DRAWINGS SPECIFICATIONS ARE THE PROPERTY OF H&K AND SHALL NOT BE REPRODUCED OR COPIED WITHOUT H&K'S WRITTEN PERMISSION.		
CUSTOMER: MCDONALD'S CORPORATION Oak Brook, Illinois	STORE NO: 27434	SHEET: 6 OF 11

SHEET NO:
AB-6