


ELITE CONSTRUCTION GROUP  
LAKE JACKSON, TX  
PHONE: 979-285-0712  
NOTE: THESE PRINTS HAVE BEEN  
REDUCED BY 50 PERCENT. SCALE  
WILL BE 50 PERCENT OF WHAT IS  
NOTED ON PLANS



LEGEND	
-----	EXISTING EQUIPMENT
-----	EXISTING TRUSSES
-----	SERVICE AREA
-----	OVERHEAD
=====	EXISTING FULL WALL
-----	EXISTING LOW WALL

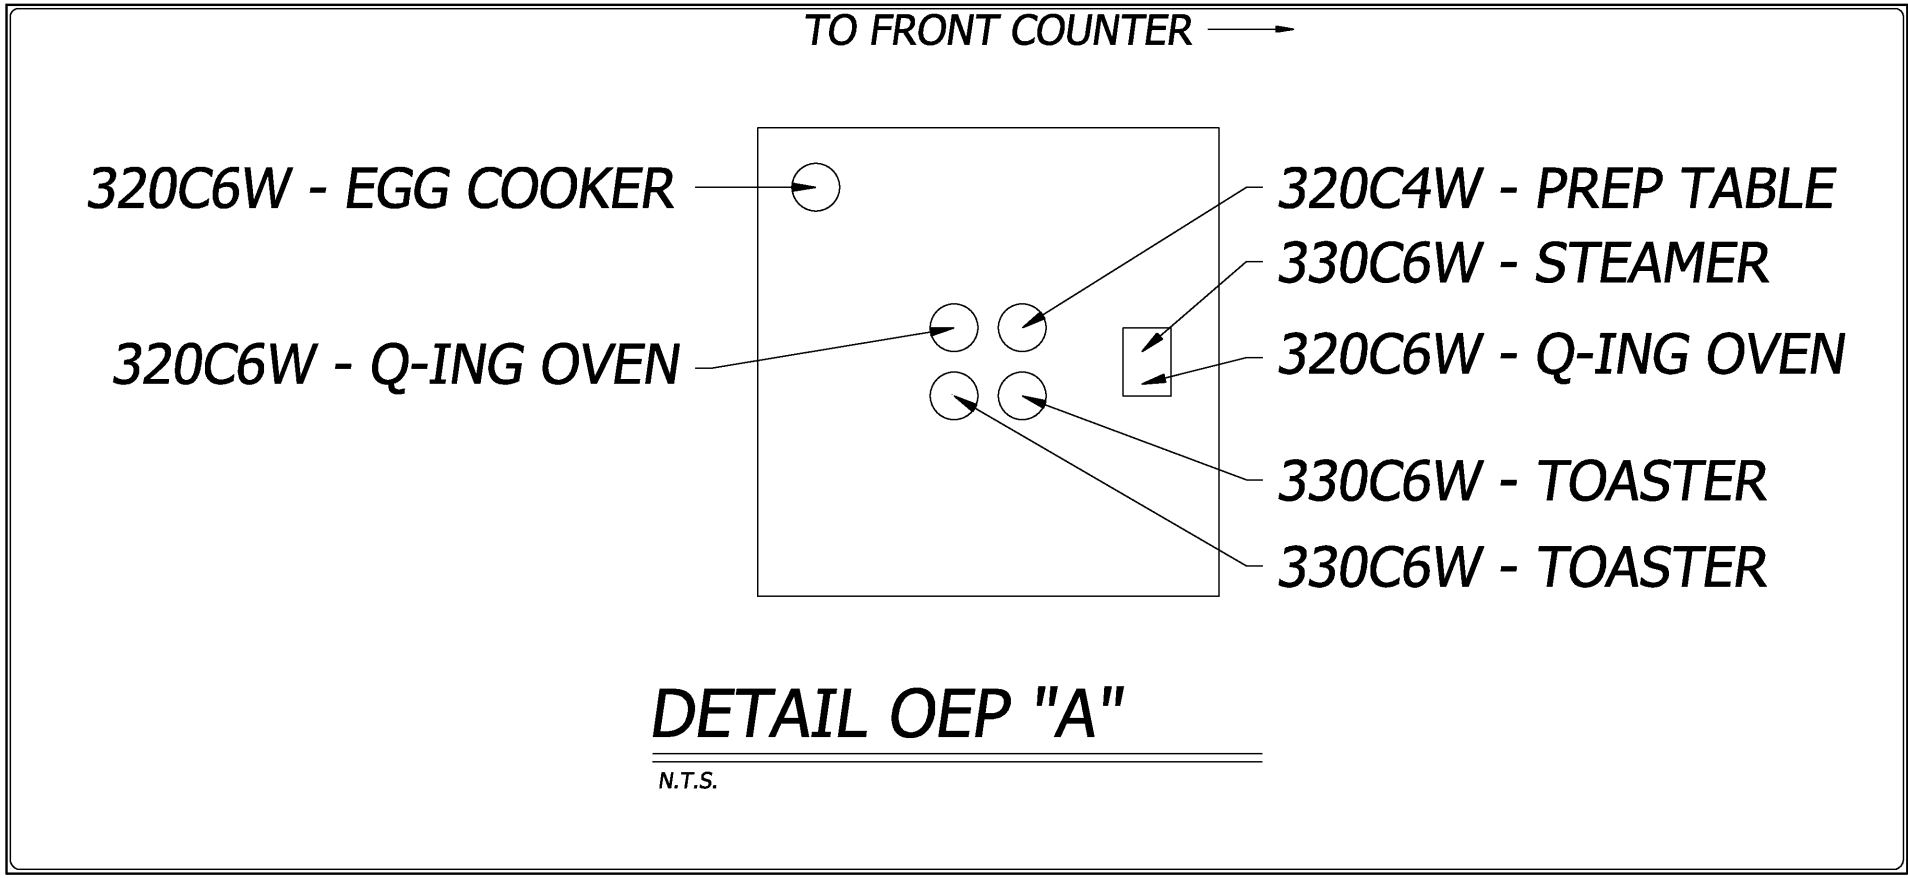

3D VIRTUAL TOUR

3D VIRTUAL TOUR LINK  
(PDF DRAWING VERSION ONLY)  
CLICK TO VIEW THE THREE  
DIMENSIONAL WALKTHROUGH  
ON YOUR BROWSER



QR CODE VIRTUAL TOUR LINK  
QR CODE ALLOWS ACCESS TO  
VIRTUAL WALKTHROUGH FROM  
PRINTED COPY IF NEEDED

 <div>H &amp; K DALLAS INC. 2200 SKYLINE DR MESQUITE, TEXAS 75149 (214) 818-5500</div>		BY		REVISION		DATE		DATE: 21APR17			
CUSTOMER: MCDONALD'S CORPORATION Oak Brook, Illinois		STORE NO: 27434		SHEET: 8 OF 11		TITLE: REMODEL DRAWING AS-BUILT LAYOUT 21320 HWY 22 WILDERSVILLE, TN		DRAWN: UA		-	
								CHECKED: BD		-	
						SCALE: SEE PLAN		-		-	
SHEET NO: AB-8										THESE DRAWINGS SPECIFICATIONS ARE THE PROPERTY OF H&K AND SHALL NOT BE REPRODUCED OR COPIED WITHOUT H&K'S WRITTEN PERMISSION.	