

1. ANY DISCREPANCIES BETWEEN THE EXISTING CONDITIONS DOCUMENTS AND THE ACTUAL FIELD CONDITIONS SHALL BE BROUGHT TO THE ATTENTION OF THE LSD&C PROJECT MANAGER BEFORE PROCEEDING WITH ANY WORK.
2. THE CONTRACTOR SHALL REVIEW ALL DOCUMENTS AND VERIFY ALL DIMENSIONS AND FIELD CONDITIONS AND SHALL CONFIRM THAT WORK IS BUILDABLE AS SHOWN. ANY CONFLICTS OR OMISSIONS, ETC., SHALL BE IMMEDIATELY REPORTED TO THE LSD&C PROJECT MANAGER FOR CLARIFICATION PRIOR TO THE PERFORMANCE OF ANY WORK IN QUESTION.
3. WHEN CONTRACTOR ACCEPTS DELIVERY OF ALL ITEMS NOTED ON PLANS WHETHER IN CONTRACT OR NOT IN CONTRACT, HE SHALL BE RESPONSIBLE FOR LOSS AND/OR DAMAGE TO THESE ITEMS.
4. THE CONTRACTOR SHALL MAINTAIN FOR THE ENTIRE DURATION OF THE WORK ALL EXITS, EXIT LIGHTING, FIRE PROTECTION DEVICES AND ALARMS IN CONFORMANCE WITH ALL APPLICABLE CODES AND ORDINANCES.
5. DURING ALL PHASES OF WORK, DO NOT DISTURB THE DELIVERIES AND FUNCTIONS OF ADJACENT AND NEIGHBORING TENANTS.
6. "TYP." SHOULD MEAN THAT THE CONDITION IS REPRESENTATIVE FOR SIMILAR CONDITIONS THROUGHOUT. UNLESS OTHERWISE NOTED, DETAILS ARE USUALLY KEYED AND NOTED "TYP." ONLY ONCE WHEN THEY FIRST OCCUR.
7. DO NOT SCALE DRAWINGS. WRITTEN DIMENSIONS TAKE PRECEDENCE OVER SCALED DIMENSIONS.
8. ARCHITECTURAL DRAWINGS TAKE PRECEDENCE OVER OTHER DRAWINGS FOR LAYOUT DIMENSIONS AND NUMBER OF ITEMS PROVIDED. UPON DISCOVERY OF DISCREPANCIES BETWEEN ARCHITECTURAL DRAWINGS AND ENGINEERING DRAWINGS, THE GENERAL CONTRACTOR SHALL NOTIFY THE LSD&C PROJECT MANAGER IMMEDIATELY.
9. DIMENSIONS SHOWN ON PLANS ARE TO FACE OF GYPSUM BOARD, CONCRETE COLUMNS OR GRID LINES AND FACE OF EXTERIOR MASONRY UNLESS OTHERWISE NOTED OR DETAILED.
10. CONTRACTOR SHALL, IN THE WORK OF ALL TRADES, PERFORM ANY AND ALL CUTTING, PATCHING RESTORING, REPAIRING AND THE LIKE NECESSARY TO COMPLETE THE WORK AND RESTORE ANY DAMAGED SURFACES RESULTING FROM THE WORK TO THEIR ORIGINAL CONDITION. ALL ROOF PATCHING SHALL RETURN AREA TO LIKE NEW CONDITION. PRIOR TO BIDDING, G.C. TO VERIFY ANY ROOF WARRANTIES WITH LANDLORD AND INCLUDE IN CONTRACT.
11. EACH CONTRACTOR SHALL LEAVE THE SITE IN A NEAT, CLEAN AND ORDERLY CONDITION UPON THE COMPLETION OF HIS WORK ON A DAILY BASIS. ALL WASTE, RUBBISH AND EXCESS MATERIALS SHALL BE REMOVED FROM THE SITE PROMPTLY. THE GENERAL CONTRACTOR SHALL BE RESPONSIBLE FOR REMOVAL AND DISPOSAL OF ALL TRASH, INCLUDING OWNER-FURNISHED ITEMS AND TRASH GENERATED BY OWNER'S CONTRACTORS FOR THE DURATION OF THE PROJECT.
12. FIRE SPRINKLER AND SIGNAGE SHOP DRAWINGS TO BE SUBMITTED UNDER SEPARATE COVER.
13. CONTRACTOR TO PROVIDE A PORTABLE FIRE EXTINGUISHER WITH A RATING OF NOT LESS THAN 2-A OR 2-A/10BC WITHIN 75' TRAVEL DISTANCE TO ALL PORTIONS OF THE BUILDING DURING CONSTRUCTION.
14. CONTRACTOR TO PROVIDE MINIMUM THREE FIRE EXTINGUISHERS (TWO IN SALES AND ONE IN NON-SALES) OR AS REQUIRED BY FIRE MARSHALL. VERIFY EXACT LOCATIONS WITH LSD&C PROJECT MANAGER PRIOR TO INSTALLATION. G.C. TO MAKE SURE ALL FIRE EXTINGUISHERS ARE CERTIFIED PRIOR TO TURNOVER OF STORE. SEE FIRE PROTECTION SPECIFICATIONS.
15. GENERAL CONTRACTOR TO PROVIDE DRAFTSTOPPING AND/OR FIREBLOCKING IF REQUIRED BY THE LOCAL JURISDICTION.
16. A 44" CLEAR AISLE SHALL BE PROVIDED AND MAINTAINED THROUGH ROOMS TO EXIT DOORS.
17. NO FOOD IS TO BE PREPARED, STORED OR SERVED ON THE PREMISES.
18. ALL SECURITY DOOR AREAS TO BE PROVIDED WITH A KEY LOCKING DEVICE SO AS TO ENABLE DOOR TO BE LOCKED IN THE OPEN POSITION AND REMAIN UNLOCKED DURING BUSINESS HOURS (WITH THE EXCEPTION OF THE REAR SERVICE DOOR).
19. ONLY PANIC HARDWARE APPROVED AND LISTED BY THE STATE FIRE MARSHALL SHALL BE INSTALLED.
20. EXIT DOORS SHALL SWING IN THE DIRECTION OF EXIT TRAVEL WHEN SERVING 50 OR MORE PERSONS.
21. DOORS OPENING INTO ONE-HOUR FIRE-RESISTIVE CORRIDOR SHALL BE PROTECTED WITH A SMOKE OR DRAFT STOP FIRE ASSEMBLY HAVING A MIN. 20 MINUTE RATING OR AS NOTED IN DOOR SCHEDULE.
22. EXIT SIGNS SHALL BE ELECTRICALLY ILLUMINATED AND THE TWO LAMPS SHALL BE ENERGIZED FROM SEPARATE CIRCUITS. ILLUMINATION SHALL NORMALLY BE PROVIDED BY THE PREMISES WIRING SYSTEM. IN THE EVENT OF FAILURE OF THIS SYSTEM, ILLUMINATION SHALL BE AUTOMATICALLY PROVIDED FROM AN EMERGENCY BACKUP SYSTEM. EMERGENCY LIGHTING SHALL GIVE A VALUE OF MINIMUM ONE FOOTCANDLE AT FLOOR LEVEL, UNIFORM THROUGHOUT EGRESS PATH.
23. FIRE DAMPERS SHALL BE PROVIDED BY MECHANICAL SUBCONTRACTOR WHERE DUCTS PENETRATE FIRE-RATED WALLS OR CEILINGS. REFER TO MECHANICAL DRAWINGS.
24. EVERY EXIT DOOR SHALL BE OPERABLE FROM THE INSIDE WITHOUT THE USE OF A KEY, TOOL, SPECIAL KNOWLEDGE, OR EFFORT.
25. BATHROOM IS NOT TO FACILITATE MORE THAN (4) EMPLOYEES.

GENERAL NOTES	N.T.S.	
	42N-A000-R00-NOTE	N 02.25.10

1. THE GENERAL CONTRACTOR SHALL ARRANGE FOR ALL INSPECTIONS AND FURNISH THE STORE MANAGER WITH THE CERTIFICATE OF OCCUPANCY. CONTRACTOR TO ALSO PROVIDE A LIST OF NAMES, ADDRESSES, AND TELEPHONE NUMBERS FOR ALL SUBCONTRACTORS, INCLUDING ALL OWNER PROVIDED SUBCONTRACTORS. A LETTER OF COMPLIANCE WITH THE AMERICANS WITH DISABILITIES ACT OR CANADIAN BARRIER FREE STANDARDS SHALL ALSO BE PROVIDED. ALL ITEMS TO BE PERMANENTLY MOUNTED IN SEPARATE 8 1/2" x 11" PICTURE FRAMES (3 TOTAL) IN MANAGER'S AREA AT FACE HEIGHT, AND ONE COPY PROVIDED TO OWNER'S PROJECT MANAGER. INCLUDE THIS INFORMATION IN THE PROJECT CLOSEOUT PACKAGE.
2. PUNCHLIST ITEMS ARE TO BE COMPLETED WITHIN 7 DAYS OF ISSUANCE AND PRIOR TO THE CONSTRUCTION COMPLETION DATE.
3. PRIOR TO STORE OPENING, THE G.C. IS RESPONSIBLE TO ARRANGE FOR A CERTIFIED INDEPENDENT BALANCING CONTRACTOR TO BALANCE H.V.A.C. SYSTEM. REFERENCE AIR BALANCE COVER FORM AND PROCEDURES LISTED ON MECHANICAL DRAWINGS. CONTRACTOR SHALL PROVIDE THE LANDLORD AND THE OWNER'S PROJECT MANAGER WITH A COPY OF THE BALANCE REPORT.
4. IF REQUIRED BY LANDLORD, THE G.C. SHALL SECURE THE NECESSARY APPROVAL OF STORE'S SPRINKLER SYSTEM FROM LANDLORD'S FIRE INSURANCE CARRIER.
5. G.C. SHALL TURN OVER (3) SETS OF KEYS TO STORE MANAGER CLEARLY MARKING EACH KEY FOR IDENTIFICATION.
6. G.C. SHALL PROVIDE A PROFESSIONAL CLEANING SERVICE FOR THE STORE AT THE TIME OF COMPLETION. STORE SHALL BE CLEANED AFTER MERCHANDISING OF THE STORE, AS REQUIRED TO RETURN TO A "DUST-FREE" CONDITION PRIOR TO OPENING.
7. G.C. SHALL EXPLAIN OPERATION OF ALL MECHANICAL SYSTEMS TO STORE MANAGER.
8. G.C. SHALL ASSEMBLE AND INSTALL REMAINING OWNER SUPPLIED FIXTURES & HARDWARE ARRIVING ON MERCHANDISE TRUCK.
9. G.C. IS RESPONSIBLE TO PROVIDE (1) 30 YARD TRASH CONTAINER FOR ALL INITIAL MERCHANDISE PACKING PRIOR TO STORE OPENING.
10. ONE (1) AS-BUILT SET OF DRAWINGS SHALL REMAIN ON SITE IN PLAN TUBE HOLDER.
11. G.C. IS RESPONSIBLE TO INSTALL CABINET SHELVES - REFER TO CABINET SECTIONS FOR SPACING.
12. IF BARRICADE IS REMOVED PRIOR TO STORE OPENING, G.C. TO INSTALL KRAFT PAPER ON INSIDE OF STOREFRONT WINDOWS AND BLACK PLASTIC ON GRILLE TO BLOCK CUSTOMER VIEWS INTO THE STORE.


TURNOVER REQUIREMENTS	N.T.S.	
	42N-A000-P00-NOTE	P 02.25.10

<b>PROJECT SCOPE:</b>	
THIS PROJECT IS THE BUILD OUT/PARTIAL REMODEL OF THE EXISTING VACANT SPACE FOR A NEW BATH & BODY WORKS STORE. WORK IS TO INCLUDE, BUT NOT BE LIMITED TO, THE PARTIAL REMODEL OF EXISTING FLOORING, WALL CONSTRUCTION, LIGHTING AND CEILINGS.	
<b>NOTE:</b>	
<b>USAGE HISTORY:</b> VACANT	
<b>PROPOSED USE:</b> BATH & BODY WORKS SPACE NUMBER(S): space numbers involved IS TO BE USED EXCLUSIVELY FOR RETAIL SALES	


SCOPE OF WORK		N.T.S.		N 02.25.10
		42N-A000-N00-NOTE		
YES	NO			
<input checked="" type="checkbox"/>	<input type="checkbox"/>	BURGLAR ALARM		
<input type="checkbox"/>	<input checked="" type="checkbox"/>	CCTV (ANALOG SYSTEM)		
<input checked="" type="checkbox"/>	<input type="checkbox"/>	CCTV (DIGITAL SYSTEM)		

SECURITY REQUIREMENTS		N.T.S.		M 02.25.10
		42N-A000-M00-NOTE		
PLAN DETAIL REFERENCE		DOOR NUMBER		
SHEET NUMBER		REVISION SYMBOL		
ADDITIONAL NOTES		REVISION CLOUD		
PLAN SECTION REFERENCE		CODED NOTE		
SHEET NUMBER		CEILING HEIGHT		
SECTION DETAIL REFERENCE		CEILING FINISH		
SHEET NUMBER		ADDITIONAL NOTES		
ADDITIONAL NOTES		FINISH CALL-OUT		
ELEVATION REFERENCE		ADDITIONAL NOTES		
SHEET NUMBER		LAYOUT ORIGIN		
ADDITIONAL NOTES				
ELEVATION HEIGHT				
LOCATION IN SPACE				
CABINET/FIXTURE TYPE				

SYMBOL LEGEND	N.T.S.	L 02.25.10
	42N-A000-L00-NOTE	

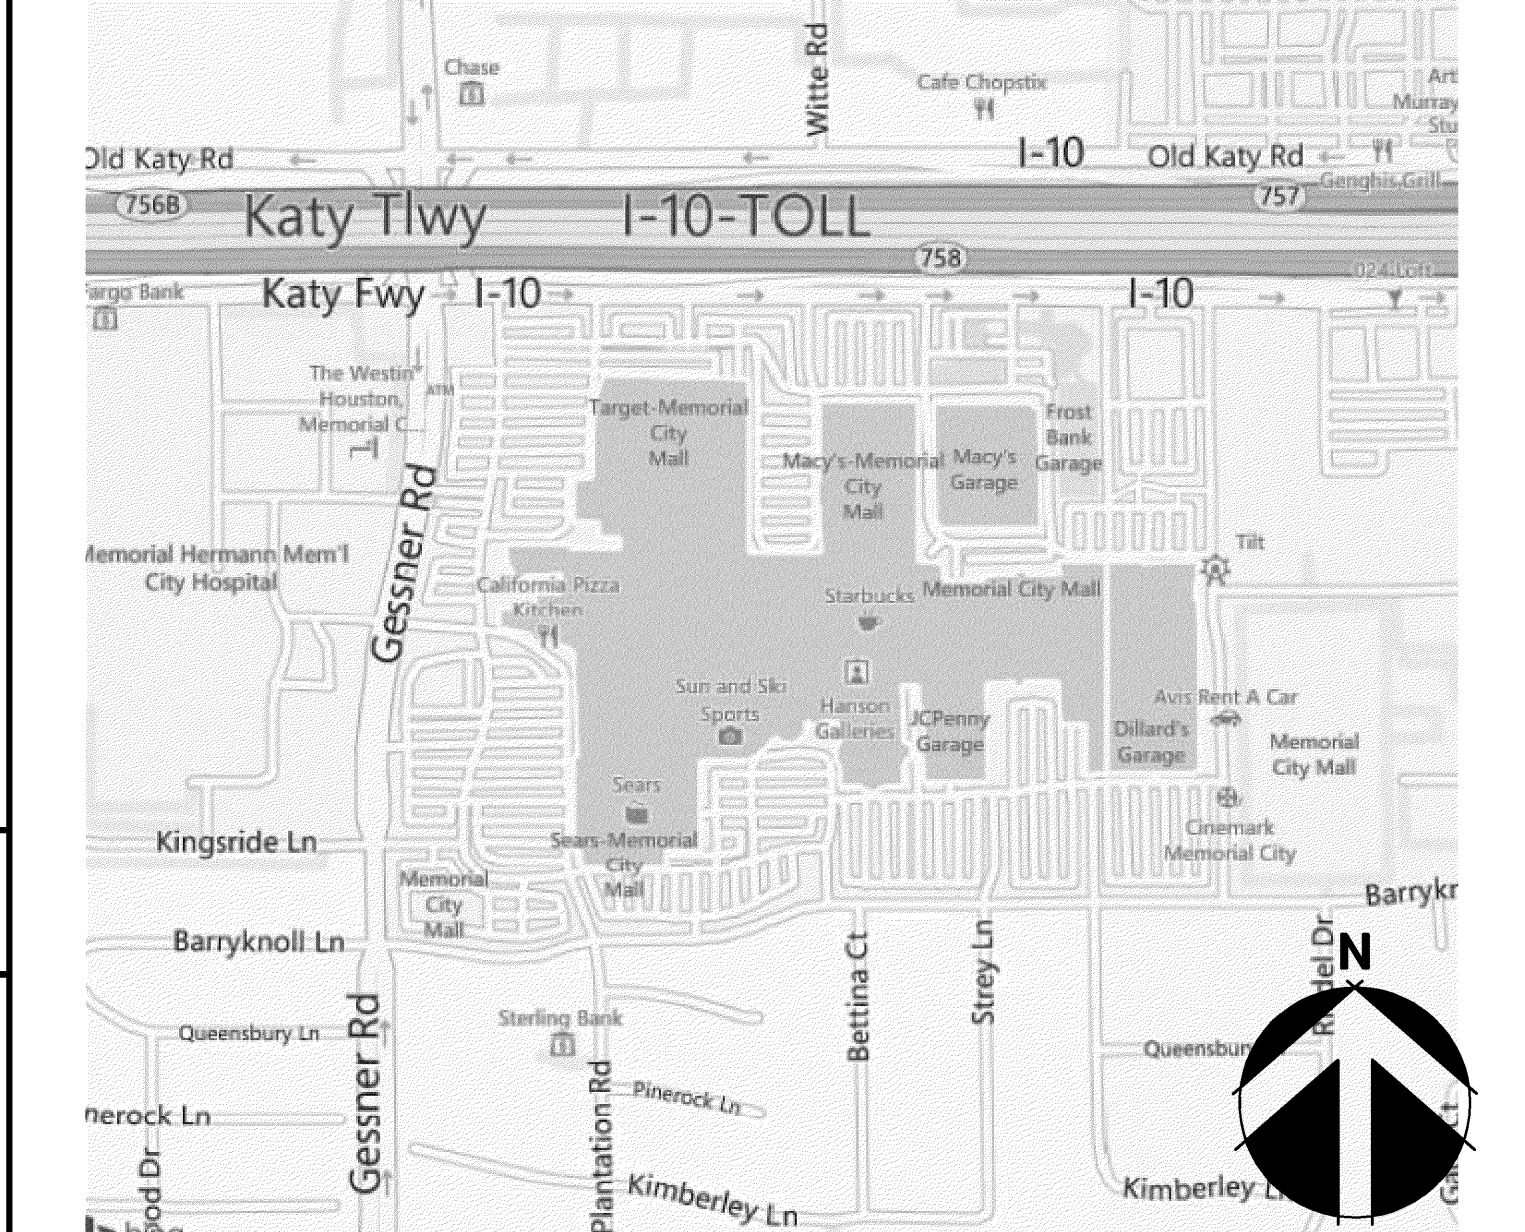

VICINITY MAP	N.T.S.	K 02.25.10
	42N-A000-K00-NOTE	

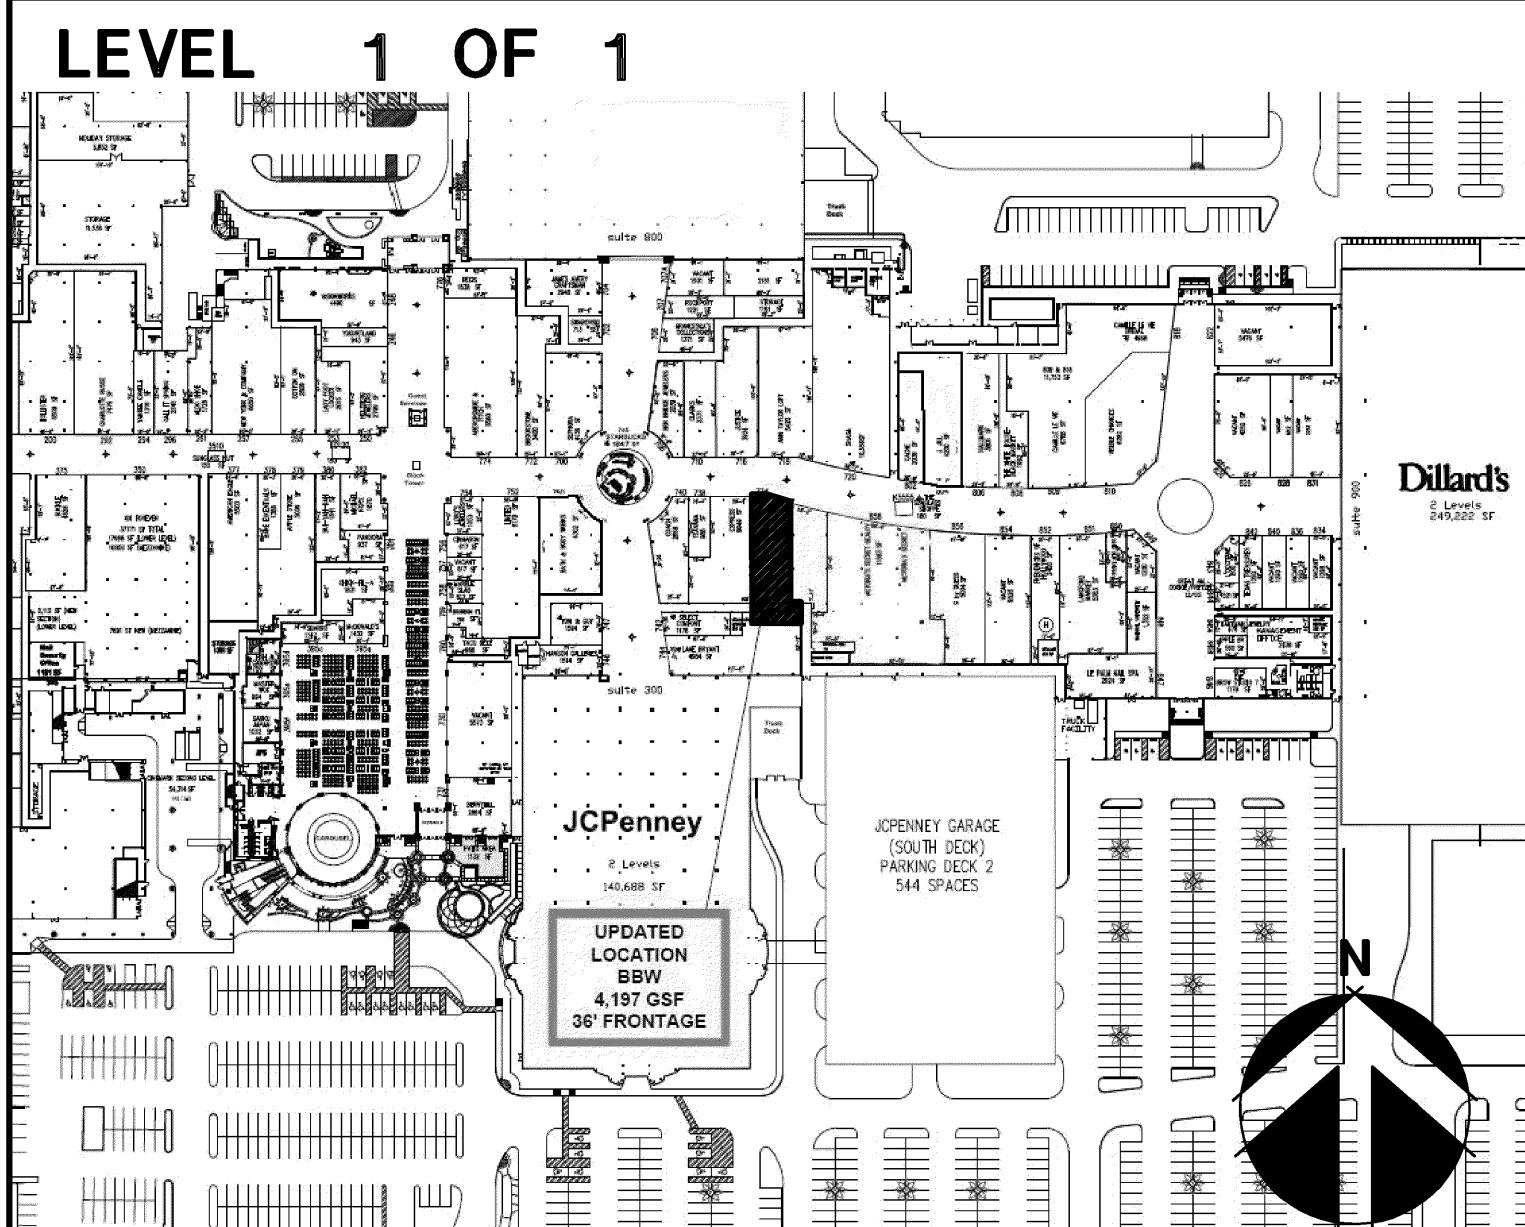

KEY PLAN	N.T.S.	J 02.25.10
	42N-A000-J00-NOTE	

SHEET		SHEET TITLE	REVISIONS					
			1	2	3	4	5	6
ARCHITECTURAL								
A00.0	COVER SHEET		●					
A00.1	RESPONSIBILITY SCHEDULE		●					
A00.2	DOOR & FINISH SCHEDULES		●					
A01.1	DEMOLITION PLAN							
A02.1	CONSTRUCTION PLAN		●					
A04.1	REFLECTED CEILING PLAN		●					
A05.1	FLOOR & WALL FINISH PLAN							
A06.1	PRESENTATION PLAN							
A07.1	INTERIOR ELEVATIONS							
A07.2	INTERIOR ELEVATIONS							
A08.1	STOREFRONT PLAN & ELEVATION		●					
A08.2	STOREFRONT GINGHAM DETAILS	⚠	●					
A08.3	STOREFRONT SECTIONS		●					
A08.4	NOT USED							
A08.5	NOT USED							
A08.6	STOREFRONT DETAILS		●					
A10.1	PERIMETER CABINETRY DETAILS							
A10.2	PERIMETER CABINETRY DETAILS							
A10.3	PERIMETER CABINETRY DETAILS							
A10.4	DEMONSTRATION SINK DETAILS							
A10.5	PASS-THRU PORTAL DETAILS							
A10.6	PASS-THRU CABINETRY DETAILS							
A11.1	CASHWRAP & BACKWRAP DETAILS							
A11.2	CASHWRAP DETAILS							
A12.1	PARTITION DETAILS							
A12.2	FLOOR, BASE & TRIM DETAILS							
A12.3	CEILING & LIGHTING DETAILS							
A13.1	TOILET ROOM DETAILS							
A14.1	STOCKROOM SHELVING DETAILS							
A14.2	STOCKROOM DETAILS							
A14.3	STOCKROOM DETAILS							
A15.1	SPECIFICATIONS							
A15.2	SPECIFICATIONS							
A15.3	SPECIFICATIONS							
A15.4	SPECIFICATIONS							

STRUCTURAL						
S01.1	STRUCTURAL SPECIFICATIONS & NOTES	●				
S02.1	STOREFRONT FRAMING PLAN & SECTIONS	●				
S02.2	STOREFRONT DETAILS & SECTIONS					
S03.1	STRUCTURAL CONSTRUCTION DETAILS					
S03.2	WALL FRAMING AT NON-SALES SHELVING					
S05.1	MECH SUPPORT FRAMING PLAN & DETAILS					

6	TOTAL STRUCTURAL SHEETS								
<b>ELECTRICAL</b>									
E01.01	ELECTRICAL NOTES AND SCHEDULES								
E02.01	ELECTRICAL POWER PLAN								
E03.01	ELECTRICAL LIGHTING PLAN								
E04.01	ELECTRICAL LIGHT FIXTURE SCHEDULE								
E04.02	ELECTRICAL DETAILS								
E05.01	ELECTRICAL PANELS & RISER DIAGRAM								

6	TOTAL ELECTRICAL SHEETS				
<b>MECHANICAL</b>					
M01.01	MECHANICAL NOTES AND SCHEDULES				
M02.01	MECHANICAL PLAN				
M03.01	MECHANICAL DETAILS				
M04.01	MECHANICAL RESPONSIBILITY SCHEDULES				
4	TOTAL MECHANICAL SHEETS				

PLUMBING						
P01.01	PLUMBING NOTES AND SCHEDULES					
P02.01	PLUMBING & FIRE SPRINKLER HEAD PLAN					
P02.02	PLUMBING ISOMETRIC DIAGRAM					
P03.01	PLUMBING AND FIRE PROTECTION DETAILS					
4	TOTAL PLUMBING SHEETS					
53	TOTAL SHEETS					

PROHIBITION ON REUSE:  
THESE DRAWINGS AND SPECIFICATIONS WERE PREPARED FOR USE ON A SPECIFIC SITE CONTEMPORANEOUSLY WITH THEIR ISSUE DATE. THEY ARE NOT INTENDED FOR USE ON A DIFFERENT PROJECT SITE OR AT A LATER TIME. REUSE OF THESE DRAWINGS AND SPECIFICATIONS, OR ANY REPRODUCTION THEREOF, ON ANOTHER PROJECT IS PROHIBITED AND CONTRARY TO LAW UNLESS EXPRESSLY AUTHORIZED IN WRITING BY LIMITED STORE PLANNING, INC. D/B/A LIMITED STORE DESIGN AND CONSTRUCTION ("LSDC"). THESE DRAWINGS AND SPECIFICATIONS ARE THE PROPERTY OF LSDC AND SHALL NOT BE DISPLAYED IN ANY MANNER OR USED ON ANY OTHER PROJECT EXCEPT BY WRITTEN AGREEMENT WITH LSDC. NO REPRODUCTION OF THESE DRAWINGS AND SPECIFICATIONS SHALL BE MADE WITHOUT THE WRITTEN AUTHORIZATION OF THE LSDC. ALL ORIGINALS OR REPRODUCTIONS OF THESE DRAWINGS AND SPECIFICATIONS MUST BE RETURNED TO LSDC UPON COMPLETION OF THEIR INTENDED USE, UNLESS OTHERWISE AGREED BY THE LSDC. COPYRIGHT NOTICE:  
THESE DRAWINGS AND SPECIFICATIONS ARE COPYRIGHTED AND SUBJECT TO COPYRIGHT PROTECTION AS AN "ARCHITECTURAL WORK" UNDER SEC. 102 OF THE COPYRIGHT ACT, 17 U.S.C. AS AMENDED DECEMBER 1990. KNOWN AS THE ARCHITECTURAL WORKS COPYRIGHT PROTECTION ACT OF 1990. THE PROTECTION INCLUDES, WITHOUT LIMITATION, THE OVERALL FORM, ARRANGEMENT AND COMPOSITION OF SPACES, AND ELEMENTS OF THE DESIGN. UNDER SUCH PROTECTION, UNAUTHORIZED USE OF THESE DRAWINGS AND SPECIFICATIONS MAY RESULT IN CESSATION OF CONSTRUCTION, BUILDING SEIZURE, AND/OR MONETARY LIABILITY.

DRAWING INDEX	N.T.S.	E 02.25.10
	42N-A000-E00-NOTE	

ABV ABOVE ACUSTICAL CEILING TILE	MAX MAXIMUM MEDIUM DENSITY FIBERBOARD
A.F.F. ABOVE FINISH FLOOR	MECH MECHANICAL
A/R ACCESSIBLE FITTING ROOM	MFG MANUFACTURER
ALUM ALUMINUM	MISC MISCELLANEOUS
A.M.I. AMERICAN WOOD INSTITUTE	MIN MINIMUM
ASTH AMERICAN SOCIETY FOR TESTING AND MATERIALS	MTD MOUNTED
	MTL METAL
BBN BATH AND BODY WORKS	N.I.C. NOT IN CONTRACT
BD BOARD	N.P. NEUTRAL PIER
BLKS BLOCKING	N. NEW
BO BOTTOM OF	N.T.S. NOT TO SCALE
B.W. BACKWRAP	
E / CL CENTERLINE	O.C. ON CENTER
CLG CEILING	O.D. OUTSIDE DIMENSION
C.M. CONSTRUCTION MANAGER	OPNG OPENING
COL COLUMN	OPP. OPPOSITE
CONC CONCRETE	PL PLATE
CONSTR CONSTRUCTION	PLEX PLEXIGLAS
CONT CONTINUOUS	PLYMD PLYWOOD
C.T.F. CUT TO FIT	PREFIN PREFINISHED
CH CASHWRAP	PM PROJECT MANAGER
C/C CENTER TO CENTER	
DIAG DIAGONAL	QTY QUANTITY
DIA DIAMETER	(R) RELOCATED
EA EACH	RAD RADIUS
ELEV ELEVATION	REQD REQUIRED
E.P.A. ENVIRONMENTAL PROTECTION AGENCY	(REF) REFERENCE
EQ EQUAL	RGS REGISTERS
EXIST(E) EXISTING	S.O. SLOUGH OPENING
EXT EXTERIOR	S.C. SOLID CORE
F.C.D. FINISHED CABINET DIMENSION	SECT SECTION
FD FLOOR DRAIN	SHT SHEET
F.D. FINISH DIMENSION	SIM SIMILAR
FHSDS FLAT HEAD SELF DRILLING SCREW	SPL SPECIAL
FIN FINISH	SQ SQUARE
FL FLOOR	50 FT / S.F. SOUND TRANSMISSION COEFFICIENT
FLG FLOORING	SSHA STEEL STUD MANUFACTURERS ASSOC.
FLUOR FLUORESCENT	STC SQUARE FEET
F.R.T. FIRE RESISTIVE TREATED	STL STEEL
FR FITTING ROOM	STRUCT SURFACE
GA GAUGE	TEMP THROUGH
G.C. GENERAL CONTRACTOR	THRU TOP OF
GYPB GYPSUM BOARD	T.O. TYPICAL
HDF HIGH DENSITY FIBERBOARD	TYP
HGT HEIGHT	
HORIZ HORIZONTAL	U.L. UNDERWRITERS LABORATORIES
H.M. HOLLOW METAL	U.O.N. UNLESS OTHERWISE NOTED
HR HOUR	
HVAC HEATING, VENTILATION, AIR CONDITIONING	V.C. VOLUME CONTROL
I.D. INSIDE DIMENSION	VERT VERTICAL
INCAND INCANDESCENT	V.I.F. VERIFY IN FIELD
INT INTERIOR	VSS VICTORIA'S SECRET
LAV LAVATORY	W/ WITH
LL LANDLORD	WD WOOD
LL LEASE LINE	W/O WITHOUT
LSDC LIMITED STORE DESIGN & CONSTRUCTION	W.I.C. WOOD INSTITUTE COUNCIL

ABBREVIATIONS	N.T.S.	D 02.25.10
	42N-A000-D00-NOTE	

**STORE TYPE:** BATH & BODY WORKS  
**LOCATION:** HOUSTON, TX  
**BUILDING LEVEL:** 1 OF 1  
**APPLICABLE CODES:** INTERNATIONAL BUILDING CODE - 2006  
UNIFORM MECHANICAL CODE - 2006  
NATIONAL ELECTRIC CODE - 2011  
UNIFORM PLUMBING CODE - 2008  
INTERNATIONAL ENERGY CONSERVATION CODE / ASHRAE 90.1 - 2009  
ADAAG 2004

<b>OCCUPANCY GROUP:</b>	MERCANTILE
<b>SEISMIC ZONE:</b>	A

<b>CONSTRUCTION TYPE:</b>	II-B
---------------------------	------

<b>FIRE RESISTIVE REQUIREMENTS:</b>	DEMISING WALL..... (1 HOUR) SALES/NON-SALES WALL... (0 HOUR) CEILING..... (0 HOUR) COLUMNS..... (0 HOUR)
-------------------------------------	---

**FIRE SPRINKLERS:** ENTIRE SALES AND NON-SALES AREA OF THE STORE IS TO RECEIVE AN AUTOMATIC FIRE SPRINKLER SYSTEM AS PER APPROVED FIRE PROTECTION PLANS.

<b>OCCUPANCY LOAD BREAKDOWN:</b>	SALES AREA: $\frac{3,229 \text{ SQUARE FEET}}{30} = 108$ NON-SALES AREA: $\frac{739 \text{ SQUARE FEET}}{300} = 3$ TOTAL = 111
----------------------------------	--

<b>REQUIRED EXITS:</b>	NUMBER OF EXITS REQUIRED: 2 NUMBER OF EXITS PROVIDED: 2
------------------------	--

<b>MAX TRAVEL DISTANCE:</b>	63 FEET
-----------------------------	---------

<b>RESTROOM REQUIREMENTS:</b>	WATER CLOSETS: 1 REQUIRED FOR UNISEX LAVATORIES: 1 REQUIRED FOR UNISEX
-------------------------------	---

URINALS..... 0	
DRINKING FOUNTAINS..... 2	
PUBLIC ACCESS..... NO	
UNISEX IS PERMITTED..... YES	

CODE SYNOPSIS	N.T.S.	C 02.25.10
	42N-A000-C00-NOTE	

**THIS SET OF DRAWINGS WAS ORIGINATED USING THE BBW 141Sa MASTERS**

BULLETIN UPDATE NO.	DRAWING ISSUANCE	BULLETIN UPDATE NO.	DRAWING ISSUANCE	BULLETIN UPDATE NO.	DRAWING ISSUANCE
X	X	X	X	X	X

BULLETIN IMPLEMENTATION	N.T.S.	B 10.14.11
	42N-A000-B00-NOTE	

<u>S.F. BREAKDOWN</u>		<u>OCCUPANT LOAD FACTOR</u>	<u>OCCUPANT LOAD</u>
1. GROSS AREA: (2 + 3 + 4) DOES NOT INCLUDE #5 UNIMPROVED AREA	<u>4,195</u>	<u>s.F. —</u>	<u>111</u>
2. SALES AREA: INCLUDES SALES FLOOR, ELEVATOR, PUBLIC STAIRS, ENTRY (VESTIBULE) # FITTING ROOMS	<u>3229</u>	<u>s.F. 30</u>	<u>108</u>
3. STOCK AREA: INCLUDES STOCK/STAGING, OFFICE(S)	<u>739</u>	<u>s.F. 300</u>	<u>3</u>
4. AUXILIARY AREA: MECH/ELEC/TELCO ROOM(S), LAVATORY(S), EXIT CORRIDORS # DUMBWAITER	<u>227</u>	<u>s.F. -</u>	<u>-</u>
5. UNIMPROVED AREA: ALL SPACE ABANDONED BY BRAND OR RETURNED TO LANDLORD	<u>0</u>	<u>s.F.</u>	
6. LINEAR FRONTAGE: INCLUDES ALL LINEAR FRONTAGE FROM NEUTRAL PIER TO NEUTRAL PIER	<u>36'-11 1/2"</u>	<u>L.F.</u>	