NOTE:
REFER TO SHEET E04.01 FOR ELECTRICAL LIGHTING SCHEDULE AND LIGHT DESCRIPTIONS.

NOTE:
REFER TO SHEET E05.01 FOR PANEL SCHEDULE AND LIGHTING ZONE DESIGNATIONS.

NOTE:
THE USE OF ROMEX, BE OR MC CABLE IS NOT PERMITTED.

1

NOTE:
ELECTRICAL CONTRACTOR SHALL REFER TO ARCHITECTURAL SHEETS FOR MOUNTING HEIGHTS AND INSTALLATION DETAILS FOR SUSPENDED LIGHTING IN NON-SALES AREA.

NOTE:
GENERAL CONTRACTOR SHALL VERIFY CEILING FIRE RATING WITH ARCHITECT, AND BOX OR TENT ALL RECESSED LIGHT FIXTURES, IF REQUIRED, TO MAINTAIN CEILING FIRE RATING.

NOTE:
CIRCUIT NONSALES EXIT, EMERGENCY AND NIGHTLIGHTS BATTERY BACKUP BALLAST TO LOCAL CIRCUIT AHEAD OF ALL SWITCH.

NOTE:
EMERGENCY FIXTURES IN PUBLIC AREAS MUST BE PROVIDED WITH REMOTE CONCEALED BATTERY PACKS.

1

1. ELECTRICAL CONTRACTOR SHALL INSTALL OCCUPANCY MOTION SENSOR SWITCH FOR CONTROL OF LIGHTS AS SHOWN. ELECTRICAL CONTRACTOR SHALL SET SWITCH FOR 15 MINUTES. MOUNT AT 44"AFF.
2. ~~BREAK-OFF CIRCUIT.~~
3. LIGHT FIXTURES TO BE INSTALLED IN MILLWORK FIXTURE, NOT IN CEILING. VERIFY WITH LSD&C. REFER TO SHEET E02.01 FOR POWER REQUIREMENTS.
4. ~~ELECTRICAL CONTRACTOR SHALL FURNISH AND INSTALL 4" JUNCTION BOX FOR TIFFANY/POSTER BOXES. REFER TO ARCHITECTURAL DRAWINGS FOR MORE INFORMATION.~~
5. ~~CONTRACTOR TO ROTATE FIXTURES SO THAT UL LABELS ARE NOT VISIBLE TO CUSTOMER.~~
6. ~~ELECTRICAL CONTRACTOR SHALL FURNISH AND INSTALL 4" JUNCTION BOX FOR SHADOW BOXES. MOUNT JUNCTION BOX BELOW SHADOW BOX FOR CONNECTION TO TRANSFORMER. REFER TO ARCHITECTURAL DRAWINGS FOR MORE INFORMATION.~~
7. ~~PROVIDE JUNCTION BOX FOR BLADE SIGN MOUNTED ON INTERIOR OF STORE, ACCESSIBLE ABOVE CEILING.~~
8. FURNISH AND INSTALL JUNCTION BOX, TOGGLE DISCONNECT SWITCH IN NON-VISIBLE LOCATION, AND FINAL CONNECTION FOR 120 VOLT SIGN. SIGN IS FURNISHED WITH INTERNAL GROUND FAULT PROTECTION BY SIGN MANUFACTURER PER N.E.C. ARTICLE 600-23b. VERIFY EXACT LOCATION OF JUNCTION BOX WITH SIGN MANUFACTURER. (REUSE EXISTING JUNCTION BOX AND CONDUIT INTO SPACE IF ALREADY INSTALLED. VERIFY IN FIELD EXACT LOCATION ON CANOPY). FOR CANOPY POWER SEE SHEET A08.01 FOR WALL PENETRATION IN ROUTING CONDUIT.

   NOTE:
   THE CIRCUIT FOR SIGNAGE MUST BE A DEDICATED ISOLATED 3-LINE CIRCUIT CONSISTING OF HOT, NEUTRAL, AND GROUND WIRES LEADING DIRECTLY TO THE PANEL.
9. PROVIDE OCCUPANCY SENSOR TO AUTOMATICALLY TURN OFF WITH 30 MINUTES OF ALL OCCUPANTS LEAVING THE SPACE.
10. CIRCUIT SALES EXIT AND EMERGENCY/NIGHT LIGHT BATTERY BACK-UP TO CIRCUIT A-1

ELECTRICAL LIGHTING PLAN KEYNOTES

NTS | 42N-E0301-D00-NOTE | D 11/11/11

20' 15' 10' 5' 0
THIS SCALE TO BE USED WHEN PLANS ARE NOT PRINTED AT 30"x42"

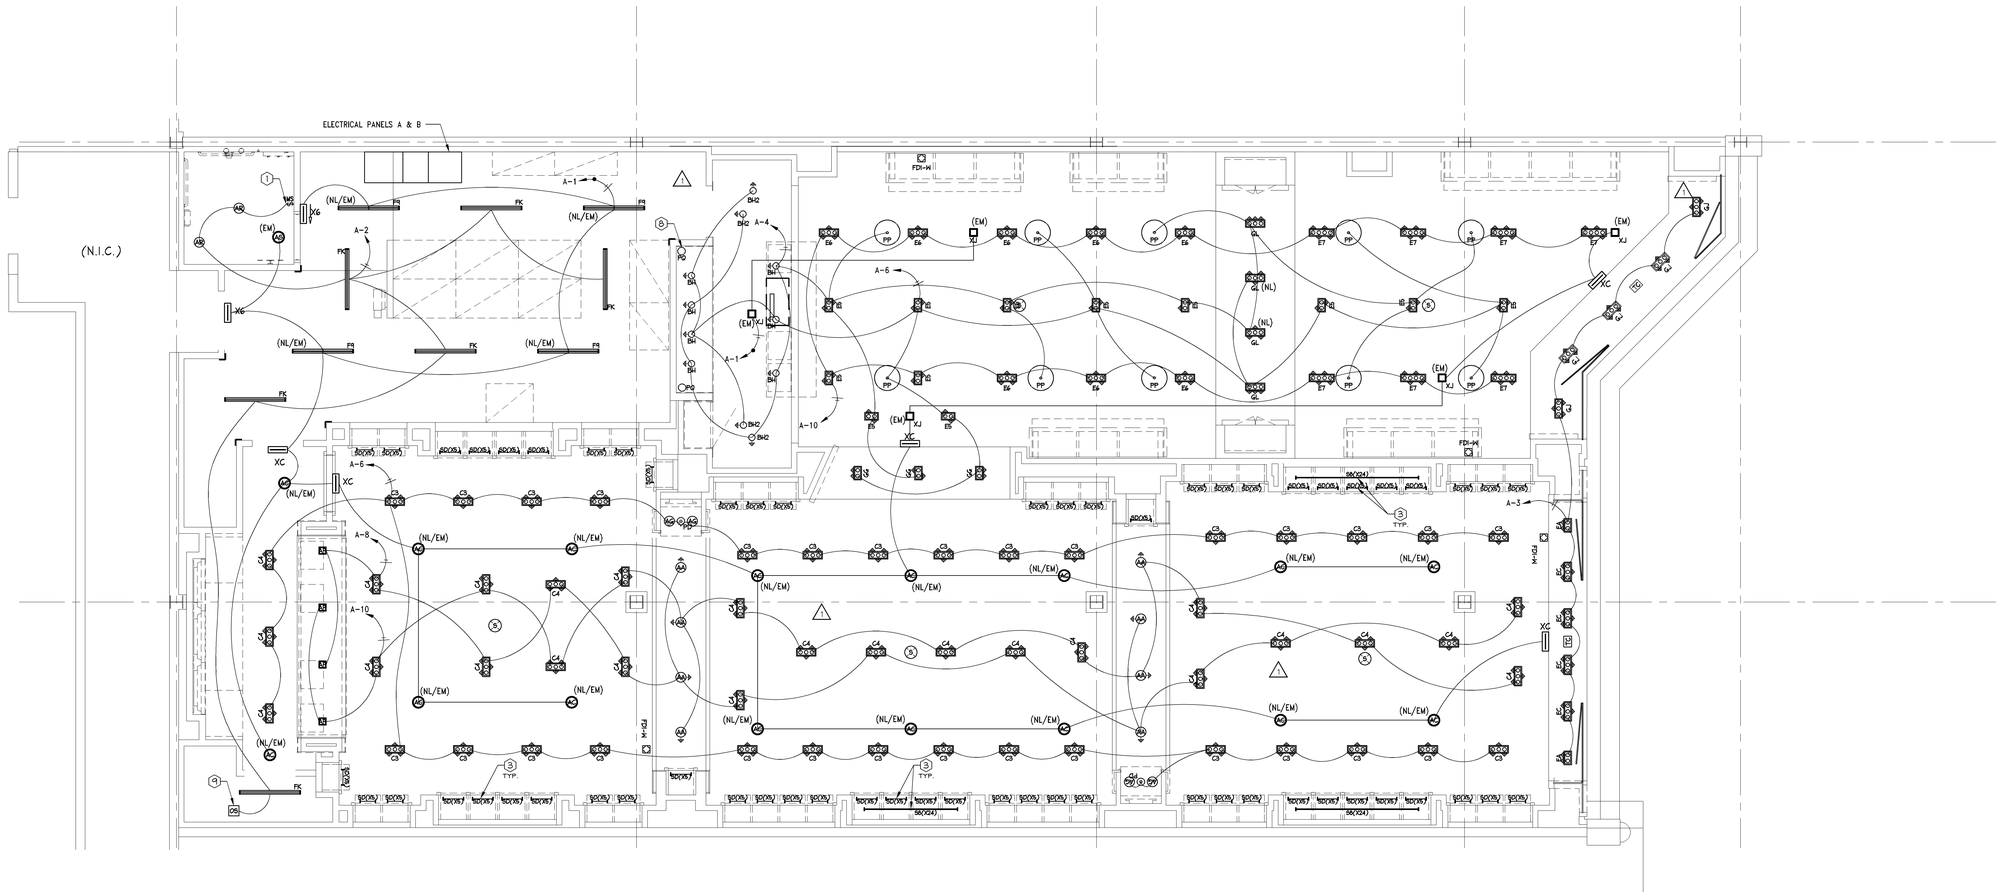

NOTE:
ALL WIRING MUST BE IN CONDUIT

"VERIFY ALL FIELD CONDITIONS PRIOR TO BID"

ELECTRICAL LIGHTING PLAN | 1/4" = 1'-0" | A

LARSON BINKLEY
Larson Binkley, Inc.
310 W 20th Street, Suite 200
Kansas City, Missouri 64108
Florida Certificate of Authorization Number 8039
T 816-997-9601
F 816-997-9602
larsonbinkley.com
Adrian T. Franks, PE0076324

Lbrands
STORE DESIGN & CONSTRUCTION
Three Limited Parkway · Columbus, Ohio 43230
Telephone: 614.415.7000 · Fax: 614.415.7349

THESE DRAWINGS AND SPECIFICATIONS ARE THE PROPERTY OF LSD&C AND SHALL NOT BE SOLD OR USED IN WHOLE OR IN PART FOR ANY PURPOSE WHATSOEVER WITHOUT THE WRITTEN CONSENT OF LSD&C. THEY ARE NOT INTENDED FOR USE ON A DIFFERENT PROJECT OR AT A DIFFERENT SITE