

- ① SECURITY SYSTEM MONITOR, REFER TO DETAIL L/M2.01 FOR MOUNTING
- ② LIGHT FIXTURE CENTERED IN CEILING.
- ③ TRAFFIC COUNTER WITH WHITE FINISH INSTALLED AT CEILING.
- ④ WALL SCONCE, REFER TO INTERIOR ELEVATIONS FOR MOUNTING HEIGHT AND LOCATION. REFER TO ELEC DRAWINGS FOR POWER REQUIREMENTS.
- ⑤ ~~NOT USED~~
- ⑥ OFFICE TASK LIGHTING PROVIDED W/ OFFICE FURNITURE PACKAGE. REFER TO ELEC. DWGS. FOR REQUIREMENTS.
- ⑦ SUSPENDED LIGHT FIXTURE ON ADJUSTABLE CABLE, BOTTOM TO BE SET @ 8'-0" A.F.F. NOTE: A MINIMUM GAP OF 9" MUST BE MAINTAINED BETWEEN FIXTURE AND CEILING.
- ⑧ FAUX SPEAKER SCREEN FOR TRANSFER OF SENSORMATIC ALARM SOUND. REFER TO SCHEDULE G/A00.04 FOR FINISH.
PINK
- ⑨ ~~LED LIGHTING INSTALLED INSIDE OF PINK OUTFITTING CENTER, REFER TO DETAIL G/A0.04 FOR PLACEMENT. REFER TO ELECTRICAL DRAWINGS FOR POWER REQUIREMENTS.~~
- ⑩ ~~2" DIA. FITTING ROOF PENDANT LIGHT FIXTURE. B.O. FIXTURE TO BE HUNG AT 2' FROM CEILING.~~
- ⑪ ~~PINK CASHIER PENDANT LIGHT FIXTURE. B.O. FIXTURE TO BE HUNG AT 2' FROM CEILING.~~
- ⑫ BUILD LETTER PINK SIGNAGE AT BACK WALL OF FOCAL. REFER TO DETAIL L/M2.01 FOR DETAILS. REFER TO ELECTRICAL DRAWINGS FOR POWER REQUIREMENTS.

- ② LED LIGHTING IN PINK ARMCHIRE FIXTURE. REFER TO DETAIL L2/A10.01 AND ELECTRICAL DRAWINGS FOR POWER REQUIREMENTS.
- ② WALL MOUNTED NEON SIGN, REFER TO ELECTRICAL DRAWINGS FOR POWER REQUIREMENTS. REFER TO DETAIL K2/A10.01 AND INTERIOR ELEVATIONS FOR MOUNTING AND ACCESS REQUIREMENTS.
- ② PINK POWDER ROOM PENDANT FIXTURE TO BE MOUNTED ABOVE LAVATORY. REFER TO DETAIL L2/A10.01 FOR P.F.F.
- ② SPARKLE LIGHT PINK SIGNS - 16 BACK WALL OF FOCAI. REFER TO DETAIL L2/A10.01 FOR DETAILS. REFER TO ELECTRICAL DRAWINGS FOR POWER REQUIREMENTS.
- VSL
- ① TRAFFIC COUNTER WITH BLACK FINISH INSTALLED AT UNDERSIDE OF SOFFIT. SEE DETAIL J/A08.15.
- ② BEAUTY SHELF LIGHTING - SEE DETAIL C/A11.03
- ③ NOT USED
- ③ VSS FITTING ROOM ABOVE PENDANT MOUNTED WITH BOTTOM AT 7' 1" A.F.F.
- ③ NOT USED
- ③ NOT USED
- ③ NOT USED
- ③ DIRECTIONAL LIGHT FIXTURE RECESSED IN VERTICAL SURFACE. REFER TO ELEVATION FOR MORE INFORMATION.
- ③ NOT USED


49 TRACK LIGHTING ATTACHED TO DRUM SHADE FIXTURE ON SITE. REFER TO
DETAIL D/A11.01.

50 VSS CASHWRAP TABLE LAMP. REFER TO ELEC DRAWINGS FOR POWER.

NOTE: ALL SECURITY CAMERAS AND DOMES ARE RECESSED FIXTURE WHICH ARE PROVIDED WITH WHITE TRIM RINGS. G.C. TO PAINT THE RING TO MATCH THE CEILING FINISH WHEN LOCATED IN A DARK CEILING ONLY.

REFER TO SHEET A00.04
FOR GENERAL NOTES AND
CEILING LEGEND
REFER TO SHEET E04.01
FOR LIGHTING SCHEDULE

	D

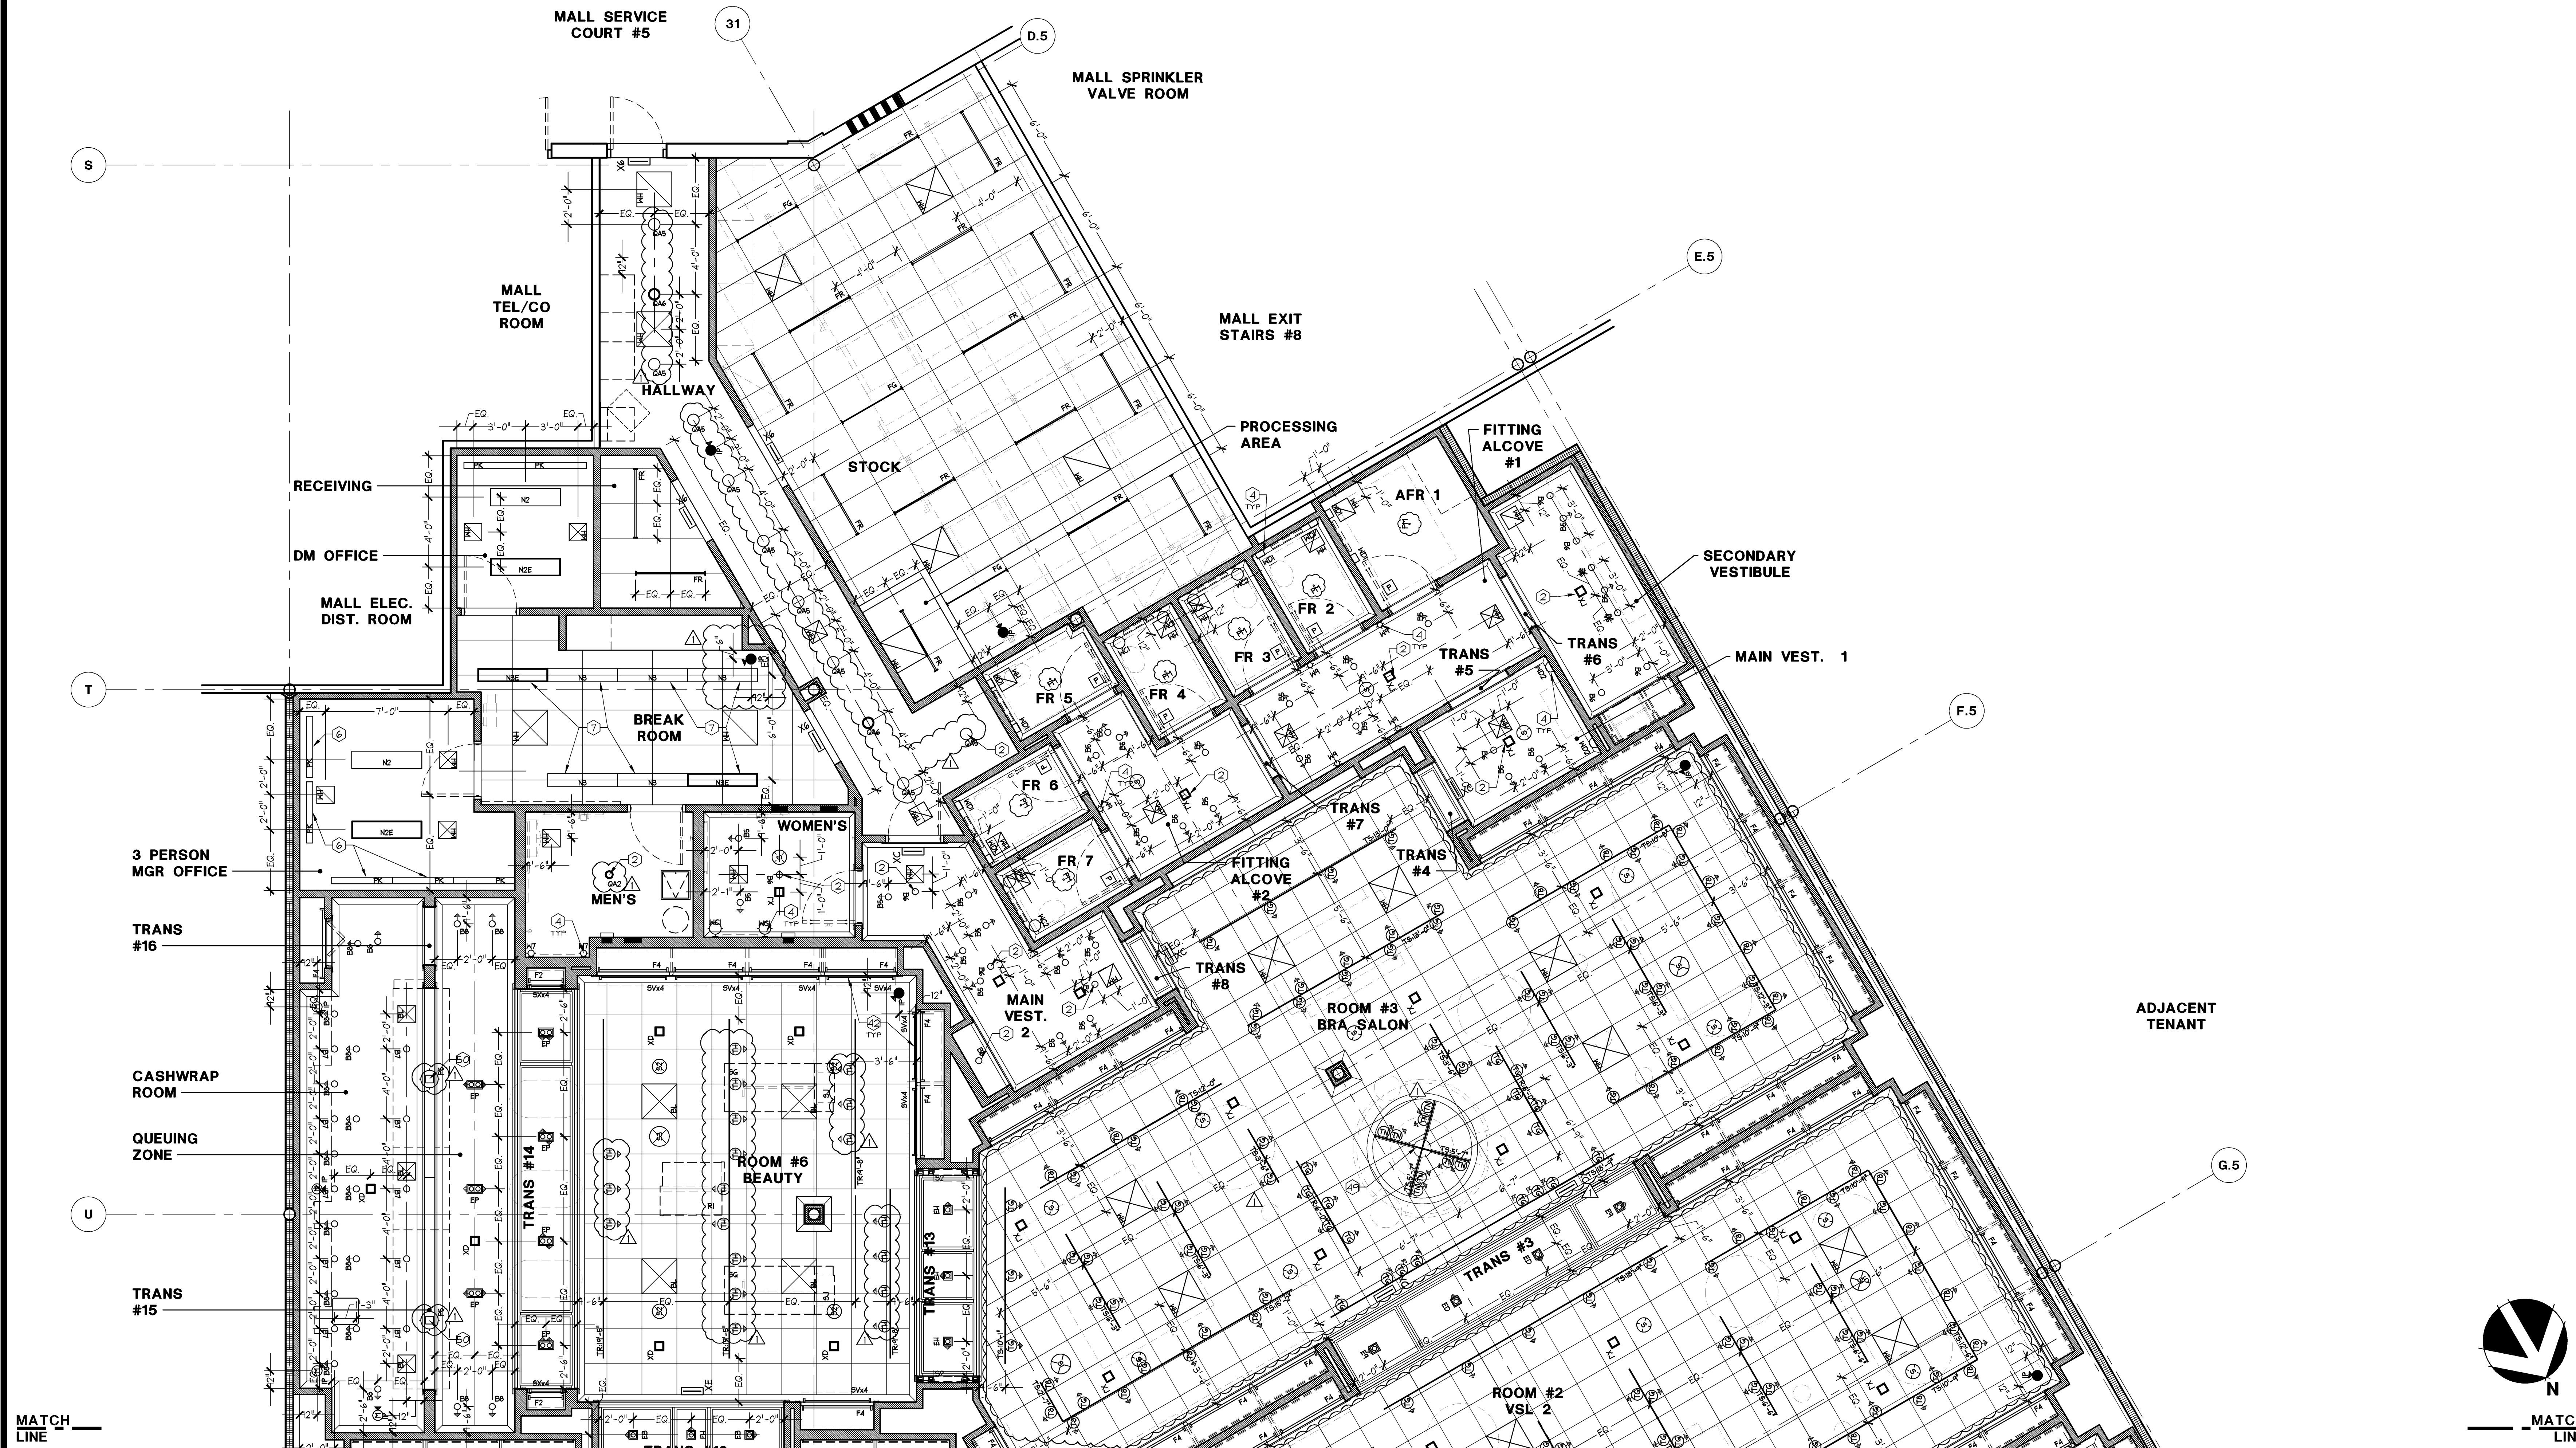

REFLECTED LIGHTING PLAN

1/4" = 1'-0"

A

Lbrands
STORE DESIGN & CONSTRUCTION
Three Limited Parkway • Columbus, Ohio 43230
Telephone: 614.415.7000 • Fax: 614.415.7349



PROJECT INFORMATION:

0105000587

VICTORIA'S SECRET

NORTH POINT MALL

SPACE #1050

1000 NORTH POINT CIRCE2

ALPHARETTA, GA 30022

SCOPE:

DESIGN TYPE:

LSDC PROJECT #:

FULL REMODEL

NMA GENERATION:

00059876 1A/E PROJECT #:

PKG II

SPRING 2015

1 40332

REVISIONS:

REQUIRED BY: _____ DATE: _____

BID ADDENDUM - LANDLORD COMMENTS
* MASTER UPDATES (1515-01 & 015-4) 01/02/2015

ELITE CONSTRUCTION GROUP
LAKE JACKSON, TX
PHONE: 979-285-0712
NOTE: THESE PRINTS HAVE BEEN
REDUCED BY 50 PERCENT. SCALE
WILL BE 50 PERCENT OF WHAT IS
NOTED ON PLANS

DATE ISSUED: 09/19/14
DESIGNED BY: CN
DRAWN BY: MJN
CHECKED BY: JM/SKM

REFLECTED LIGHTING PLAN

DRAWING NUMBER:

A04.02