GENERAL

1. LEASE LINE
2. ~~(E) MALL NEUTRAL PIER TO REMAIN, G.C. TO PATCH AND REPAIR AS REQD~~
3. (E) MALL BULKHEAD TO REMAIN, G.C. TO PATCH AND REPAIR AS REQD
4. 3/4" X 3/4" WHITE METAL REVEAL, FASTENERS SHALL MATCH REVEAL COLOR.
5. ~~3/4" X 3/4" BLACK METAL REVEAL, FASTENERS SHALL MATCH REVEAL COLOR.~~
6. 1/2" THICK CLEAR TEMPERED GLAZING
7. ~~5/8" THICK CLEAR TEMPERED GLAZING~~
8. ~~3/4" THICK CLEAR TEMPERED GLAZING~~
9. ~~1" THICK CLEAR TEMPERED INSULATED GLAZING~~
10. ~~UV FILM - REFER TO SPECIFICATIONS SECTION 088100.~~
11. OPENING OF ROLLING GRILLE, SEE SCHEDULE A/A00.02
12. LOCATION OF ROLLING GRILLE KEY SWITCH. REFER TO ELEVATIONS / SECTIONS FOR MOUNTING HEIGHT
13. ~~1/8" CAULK JOINT. REFER TO FINISH SCHEDULE FOR COLOR AND SPEC.~~
14. FRONT ACCESS DISPLAY WINDOW. SEE SCHEDULE A/A00.02
15. (N) MALL BULKHEAD PER MALL SPECIFICATION (TO MATCH EXISTING) BY G.C.
16. (E) MALL LINEAR SLOT DIFFUSER TO REMIAN (TYP.)
17. (E) MALL TRACK LIGHT TO REMAIN
18. (E) FIRE STROBE ANNUNCIATOR TO BE RELOCATED (VERIFY)

PINK

21. PRIMED WOOD MULLION. G.C. TO PAINT P-67
22. PINK GOLDLEAF VINYL WINDOW GRAPHIC APPLIED TO TENANT SIDE OF GLASS, CENTERED ON WINDOW.
23. ~~PAIR OF PRE FINISHED WOOD DOORS AND PRIMED JAMBS. SEE A/A00.02 FOR SCHEDULE. G.C. TO PAINT JAMBS ONLY.~~
24. HDF PANEL AND WOOD TRIM - G.C. TO PAINT P-67 (ALL STOREFRONT MILLWORK, U.O.N.) REFER TO STOREFRONT DETAILS.
25. INDIVIDUAL WOOD PLANKS. G.C. TO CUT DOWN PLANKS TO +/- 6'-0" LENGTHS, INSTALL W/ RANDOM SEAMS (NO SEAMS W/IN 6" OF ANOTHER). PRIME & PAINT P-60
26. THIN-SET BRICK SF-32 ON GLEN-GERY THIN TECH PANEL (CLASSIC SERIES OR EQ), PAINT P-63
27. OUTLINE OF WINDOW WALL. REFER TO DETAIL N/A08.20.
28. BULLNOSE WINDOW SILL TRIM. G.C. TO PAINT P-67
29. RADIUS TRIM PACKAGE WITH DOG.
30. AZEK BASE. G.C. TO PAINT P-67
31. DOT WALLCOVERING WC-33 SEE ELEVATIONS ON A07.XX AND CEILING PLAN ON A03.XX.
32. PINK SIGNAGE - HALO ILLUMINATED PINK MOUNTED 'PINK' LETTERS, SIZE AS INDICATED ON ELEVATION
33. DOT WALLCOVERING PANEL AT UPPER SECTION WC-33 G.C. TO PAINT LOWER SECTION P-67

34. ~~NOT USED~~
35. ~~DOT WALLCOVERING INSTALLED IN DISPLAY WINDOW. WC-31~~
36. ~~THIN-SET BRICK SF-32 ON GLEN-GERY THIN TECH PANEL (CLASSIC SERIES OR EQ), PAINTED BY G.C. P-60 (OWNER TO PAINT WHITE BOTH).~~
37. ~~DOT WALLCOVERING INSTALLED IN DISPLAY WINDOW. AC-56~~
38. MARKETING PIPE RAIL, G.C. TO PAINT REFER TO DETAIL P/A10.01. P-64
39. ~~FIXED PRE-FINISHED ALUMINUM STILE WINDOW W/ 3/8" GLASS~~
40. ~~NOT USED~~

VSL

61. 1/4" EXPOSED BUTT JOINT W/ EXPOSED BLACK CHERRY MULLION BEHIND. ALL EDGES TO BE POLISHED. DO NOT FILL JOINT.
62. 1/4" EXPOSED BUTT JOINT. MULLION BEHIND JOINT TO RECEIVE WHITE TAPE BEHIND JOINT TO COVER BLACK CHERRY METAL SURFACE. ALL EDGES TO BE POLISHED. DO NOT FILL JOINT.
63. 1/4" EXPOSED BUTT JOINT, W/ NO MULLION BEHIND. ALL EDGES TO BE POLISHED. DO NOT FILL JOINT.

64. ~~PRE-FINISHED DECORATIVE METAL PROFILE.~~
65. MARKETING GRID ABOVE SHOWN DASHED. SEE C/A08.16
66. ~~NOT USED~~
67. ~~VSS SIGNAGE - 1/4" THICK SURFACE MOUNTED POLISHED ALUMINUM LETTERS ADHERED TO GLASS. SIZE AS INDICATED IN ELEV.~~
68. LIGHTBOX TOWER FIXTURE.
69. ~~PAIR OF SWING DOORS, W/ PRE FINISHED TOP AND BOTTOM RAILS. SEE A/A00.02 FOR SCHEDULE SF-29~~
70. ~~PRE-FINISHED SIDELITE BASE AND CHANNEL SF-29~~
71. PRE-FINISHED ALUMINUM MULLION W/ CAP SF-27
72. 3/8" FINISH PANEL SF-37
73. PRE-FINISHED BREAK METAL. REFER TO DETAILS FOR SHAPES AND SIZES. SF-27
74. NOT USED
75. PRE-FINISHED METAL BASE SF-27
76. VSS PORTAL SIGNAGE - SURFACE MOUNTED FACE LIT WHITE LED LETTER W/ BLACK CHERRY RETURNS, SIZE AS INDICATED IN ELEV.
77. PRE-FINISHED METAL AT NEUTRAL BAND REFER TO DETAILS FOR SHAPES AND SIZES. SF-27
78. 1/2" LAMINATED RIBBON GLASS: RIBBON PVB BETWEEN (2) 1/4" GLASS LITES, WITH WHITE OPACICOAT BACKING. SF-36
79. 1/2" TEMPERED GLASS WITH BLACK CHERRY OPACICOAT BACKING. SF-35
80. VSG SIGNAGE - 3/8" THICK SURFACE MOUNTED CHROME LAMINATED ACRYLIC LETTERS W/ FLAME POLISHED RETURNS. SIZE AS INDICATED IN ELEVATION.
81. 2" x 2" SQUARE 1/4" x 1/4" STEEL FRONT ACCESSIBLE STOREFRONT WIRENE FIXTURE. REFER TO ELEC. DWGS. FOR POWER REQUIREMENTS.

NOT USED | **S**

STOREFRONT ELEVATION KEYNOTES | 05E-A0801-D00-ELEV | **D** 04.25.14

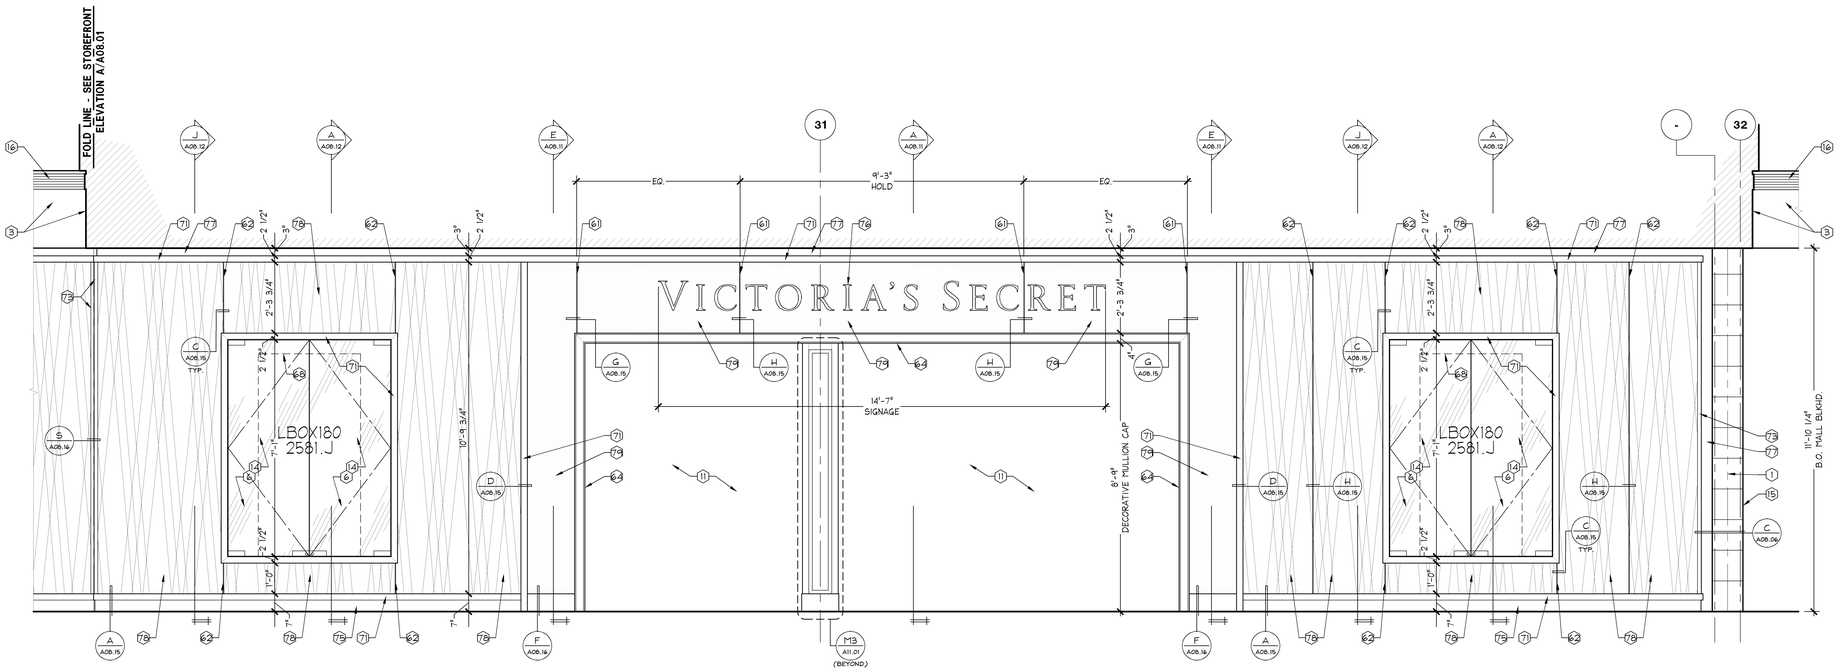

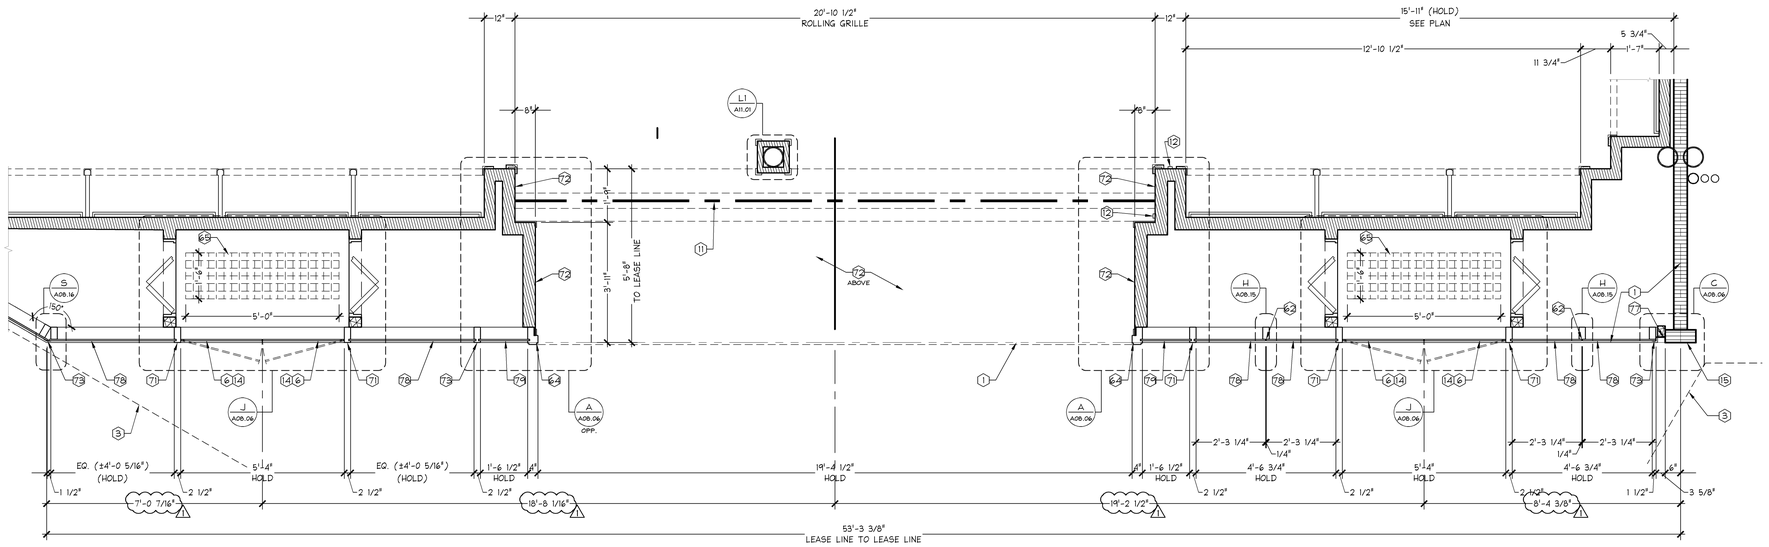

STOREFRONT ELEVATION | 1/2" = 1'-0" | **A**

SHREMSHOCK
Shremshock Architects, Inc.
7409 W. Campus Rd. Suite 150 New Albany, OH 43054
t: 614 545 4550 | f: 614 545 4555 | shremshock.com
Timothy J. Shremshock, Architect | #13585

Lbrands
STORE DESIGN & CONSTRUCTION
Three Limited Parkway · Columbus, Ohio 43230
Telephone: 614.415.7000 · Fax: 614.415.7349

PROHIBITION ON USE:
THESE DRAWINGS AND SPECIFICATIONS WERE PREPARED FOR USE ON A SPECIFIC SITE, CONTEMPORANEOUSLY WITH THEIR ISSUE DATE. THEY ARE NOT INTENDED FOR USE ON A DIFFERENT PROJECT OR SITE AND SHALL NOT BE USED IN PART OR WHOLE FOR ANY OTHER PROJECT WITHOUT THE WRITTEN AUTHORIZATION OF LSDAC. ANY REPRODUCTION OF THESE DRAWINGS AND SPECIFICATIONS SHALL BE VOID AND OF NO REPRESENTATION OR WARRANTY WHATSOEVER BY LSDAC, INC. (REFERRED TO HEREIN AS "LSDAC").

THESE DRAWINGS AND SPECIFICATIONS ARE THE PROPERTY OF LSDAC AND SHALL NOT BE SOLD/USED IN ANY MANNER BY ANY PERSON OR ENTITY WITHOUT THE EXPRESS WRITTEN PERMISSION OF LSDAC. ANY REPRODUCTION OF THESE DRAWINGS AND SPECIFICATIONS SHALL BE VOID AND OF NO REPRESENTATION OR WARRANTY WHATSOEVER BY LSDAC. THESE DRAWINGS AND SPECIFICATIONS MUST BE RETURNED TO LSDAC UPON COMPLETION OF THEIR INTENDED USE, UNLESS OTHERWISE AGREED TO BY LSDAC.

THESE DRAWINGS AND SPECIFICATIONS ARE COPYRIGHTED AND SUBJECT TO COPYRIGHT PROTECTION AS AN "ARCHITECTURAL WORK" UNDER SEC. 102 OF THE COPYRIGHT ACT, 17 U.S.C. AS AMENDED DECEMBER 1990. THE OWNER AND USER AGREE TO HOLD LSDAC AND ITS OFFICERS, DIRECTORS, EMPLOYEES AND AGENTS HARMLESS, INCLUDING WITHOUT LIMITATION, THE OVERALL FORM, ARRANGEMENT AND COMPOSITION OF SPACES, AND PLACEMENT AND COMPOSITION OF ELEMENTS AND DETAILS IN THESE DRAWINGS AND SPECIFICATIONS. ANY USE OF THESE SPECIFICATIONS MAY RESULT IN CESSATION OF CONSTRUCTION, BUILDING SEIZURE, AND/OR MONETARY DAMAGES.

010500587

PROJECT INFORMATION:
VICTORIA'S SECRET
NORTH POINT MALL
SPACE #1050
1000 NORTH POINT CIRCLE
ALPHARETTA, GA 30022

SCOPE: FULL REMODEL | PACKAGE: PKG II
DESIGN TYPE: NNA | GENERATION: SPRING 2015 (142Fo)
LSDAC PROJECT #: 00059876 | A/E PROJECT #: 140332

REVISIONS:

	REQUIRED BY:	DATE:
1	BID ADDENDUM – LANDLORD COMMENTS & MASTER UPDATES (1515a.01 & 015a)	01/02/2015

ELITE CONSTRUCTION GROUP
LAKE JACKSON, TX.
PHONE: 979-285-0712
NOTE: THESE PRINTS HAVE BEEN REDUCED BY 50 PERCENT. SCALE WILL BE 50 PERCENT OF WHAT IS NOTED ON PLANS

DATE ISSUED: 09/19/14
DESIGNED BY: CN
DRAWN BY: CAB
CHECKED BY: JM

STOREFRONT ELEVATION

DRAWING NUMBER:
A08.02