


AREA MAP




AERIAL MAP

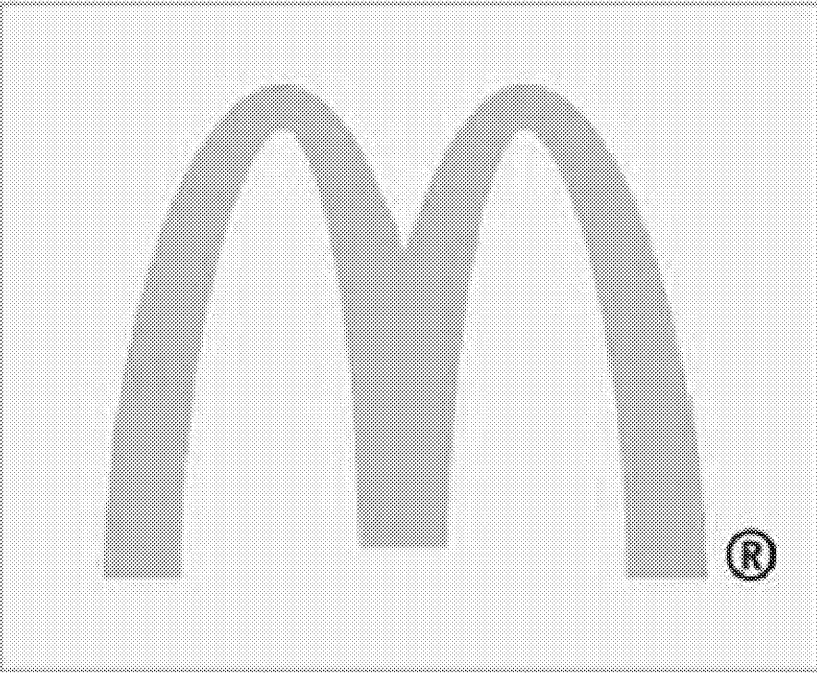

AS-BUILT SURVEY, PHOTOS & VIRTUAL TOUR

NATIONAL STORE #: 27434
COOP: MEMPHIS
ADDRESS: 21320 HWY 22
CITY: WILDERSVILLE, TN
STORE SQUARE FOOTAGE: 3130 SQ. FT.

PREPARED BY:

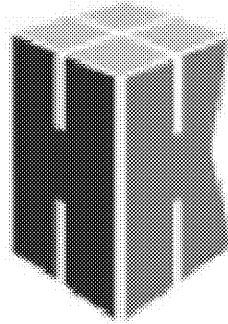


H&K INTERNATIONAL
RESTAURANT EQUIPMENT SYSTEMS WORLDWIDE

ELITE CONSTRUCTION GROUP
LAKE JACKSON, TX
PHONE: 979-285-0712
NOTE: THESE PRINTS HAVE BEEN
REDUCED BY 50 PERCENT. SCALE
WILL BE 50 PERCENT OF WHAT IS
NOTED ON PLANS



STOREFRONT PHOTO

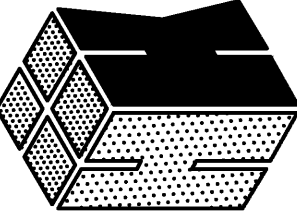 H & K DALLAS INC. 2200 SKYLINE DR MESQUITE, TEXAS 75149 (214) 818-3900			
DATE: 21APR17	DATE	REVISION	BY
DRAWN: UA	-	-	-
CHECKED: BD	-	-	-
SCALE: SEE PLAN	-	-	-
TITLE: REMODEL DRAWING AS-BUILT LAYOUT 21320 HWY 22 WILDERSVILLE, TN		CUSTOMER: MCDONALD'S CORPORATION Oak Brook, Illinois	
STORE NO: 27434		SHEET: 1 OF 11	
SHEET NO: AB-1			